


SS

Tonaka Screens 9/27/10

prepare for graph	Sort Geography Order 9 27-10	MPIS List GROUND WATER	Estimate of GS if 3 ft standpipe (TOC-3 feet)	Screen top elev	Screen Bottom Elev	of GS if 3 ft standpipe (TOC-3 feet)	Screen top elev	Screen Bottom Elev	MPIS List GROUND WATER	
	1	1				27.51	11	1		
	2	2	B33-2	29.1	27	29.82	11	1	B33-2	B33-1
	3	3				30.3	13	3	B6-2	B8-2
	4	4	B11	27.63	27	28.81	13	8	B11	B-2
	5	5	B34-2	28.21	26	28.18	9	-1	B34-2	B34-1
	6	6	B63-2	27.42	25	27.06	11	1	B63-2	B63-1
	7	8	B-5	29.66	15				B-5	
	8	9				26.27	8	-4	B36	B36
	9	10	B37-2	25.72	24	25.59	2	-8	B37-2	B37-1
	10	11	B64	25.19	23				B64	
	11	12	B38-2	25.08	23	25.22	1	-9	B38-2	B38-1
	12	13	B-39	26.06	24				B-39	
	13	14	B40-2	24.68	23	24.64	10	0	B40-2	B40-1
	14	15	B65	25.04	23				B65	
	15	16	B41-2	26.26	24	26.14	2	-8	B41-2	B41-1
	16	17	B1-B	24.31	21				B1-B	IB
	17	18	B42-2	25.36	23	25.5	9	-1	B42-2	B42-1
	18	19	MO5-B			26.24	2	-3	MO5-B	MO5-B
	19	20	B43-2	25.21	23	25.07	11	1	B43-2	B43-1
	20	21	B44	27.02	25				B44	
	21	22	B45-2	27.31	25	27.24	5	-5	B45-2	B45-1
	22	23	B66	28.27	26				B66	
	23	24	B62-2						B62-2	B62-1
	24	25	B61R	36.82	25				B61R	
	25	33				25.84	9	-1		B60
	26	35				26.73	10	0		B68

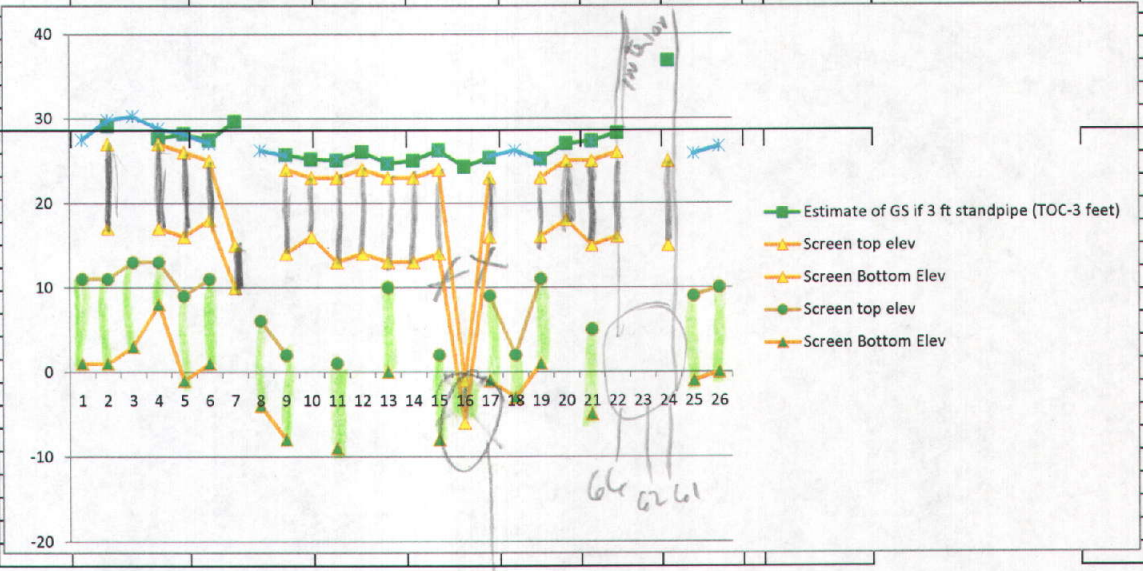

closed over low zone

Geosynthetic fabric

North III

11/20/12

with Screen Dept Chud 9/27/12

