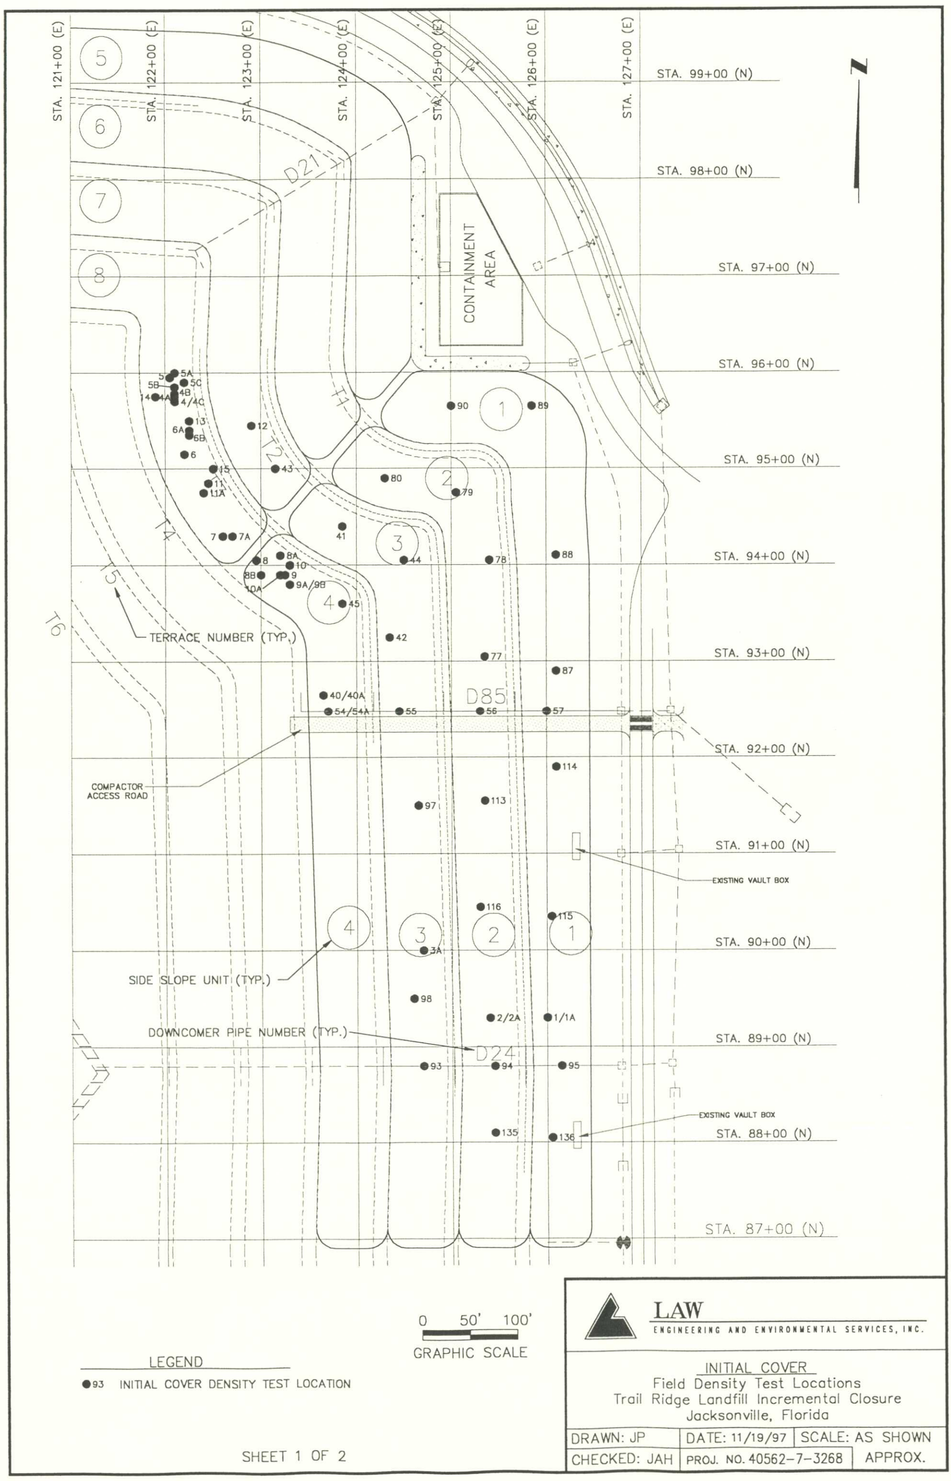


0 50' 100'
GRAPHIC SCALE


LEGEND
●93 INITIAL COVER DENSITY TEST LOCATION

SHEET 1 OF 2

LAW
ENGINEERING AND ENVIRONMENTAL SERVICES, INC.

INITIAL COVER
Field Density Test Locations
Trail Ridge Landfill Incremental Closure
Jacksonville, Florida

DRAWN: JP	DATE: 11/19/97	SCALE: AS SHOWN
CHECKED: JAH	PROJ. NO. 40562-7-3268	APPROX.

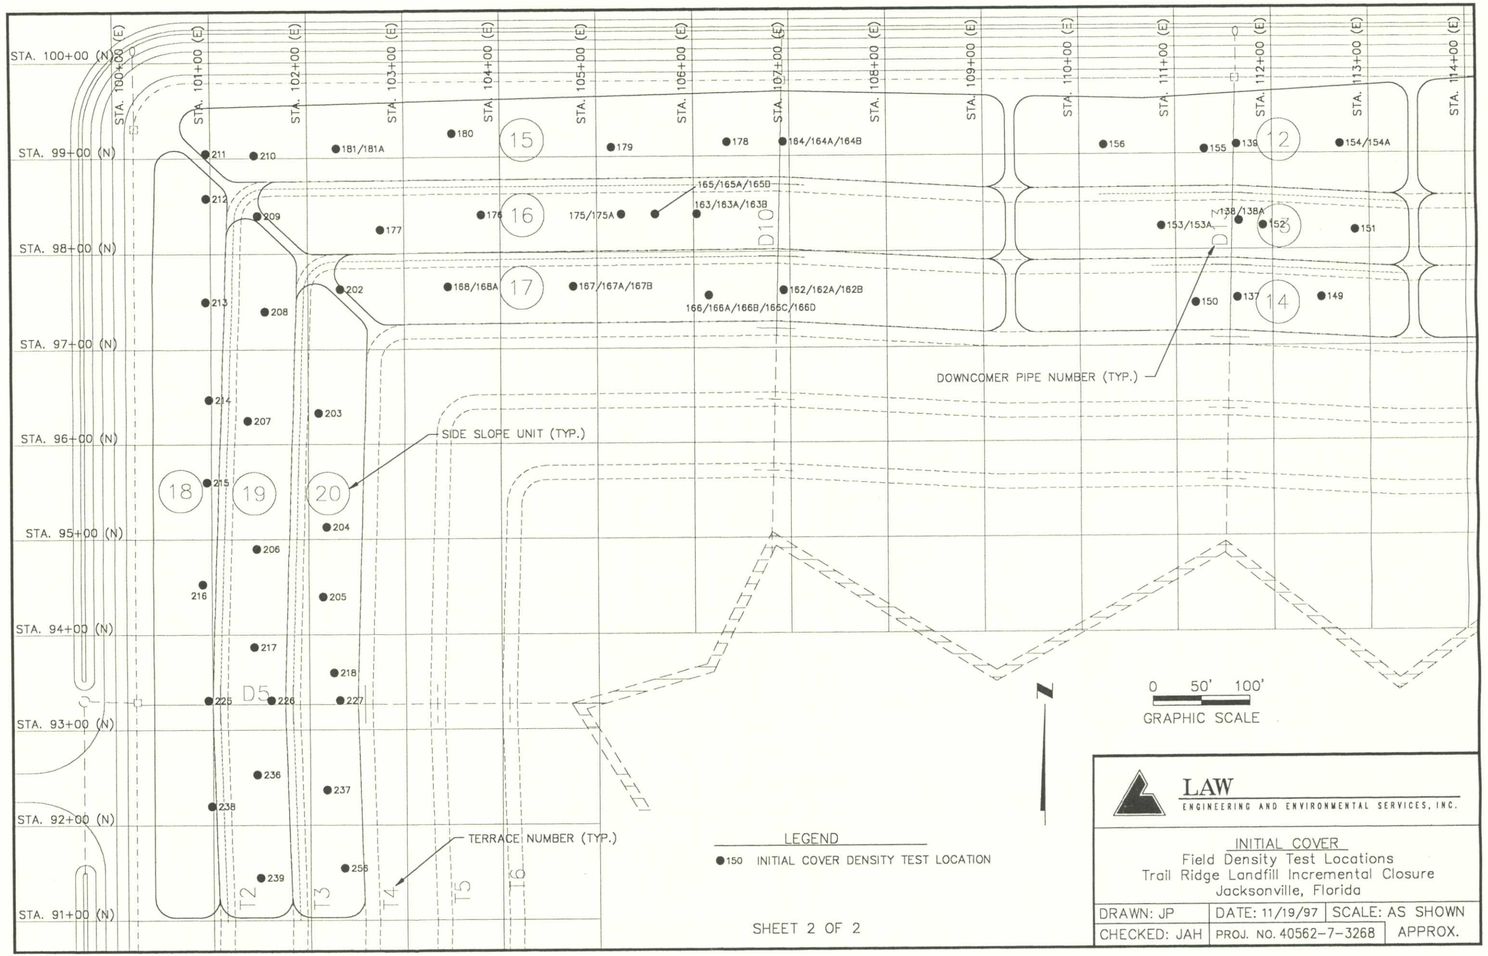


SHEET 2 OF 2

LAW
ENGINEERING AND ENVIRONMENTAL SERVICES, INC.

INITIAL COVER
Field Density Test Locations
Trail Ridge Landfill Incremental Closure
Jacksonville, Florida

DRAWN: JP	DATE: 11/19/97	SCALE: AS SHOWN
CHECKED: JAH	PROJ. NO. 40562-7-3268	APPROX.

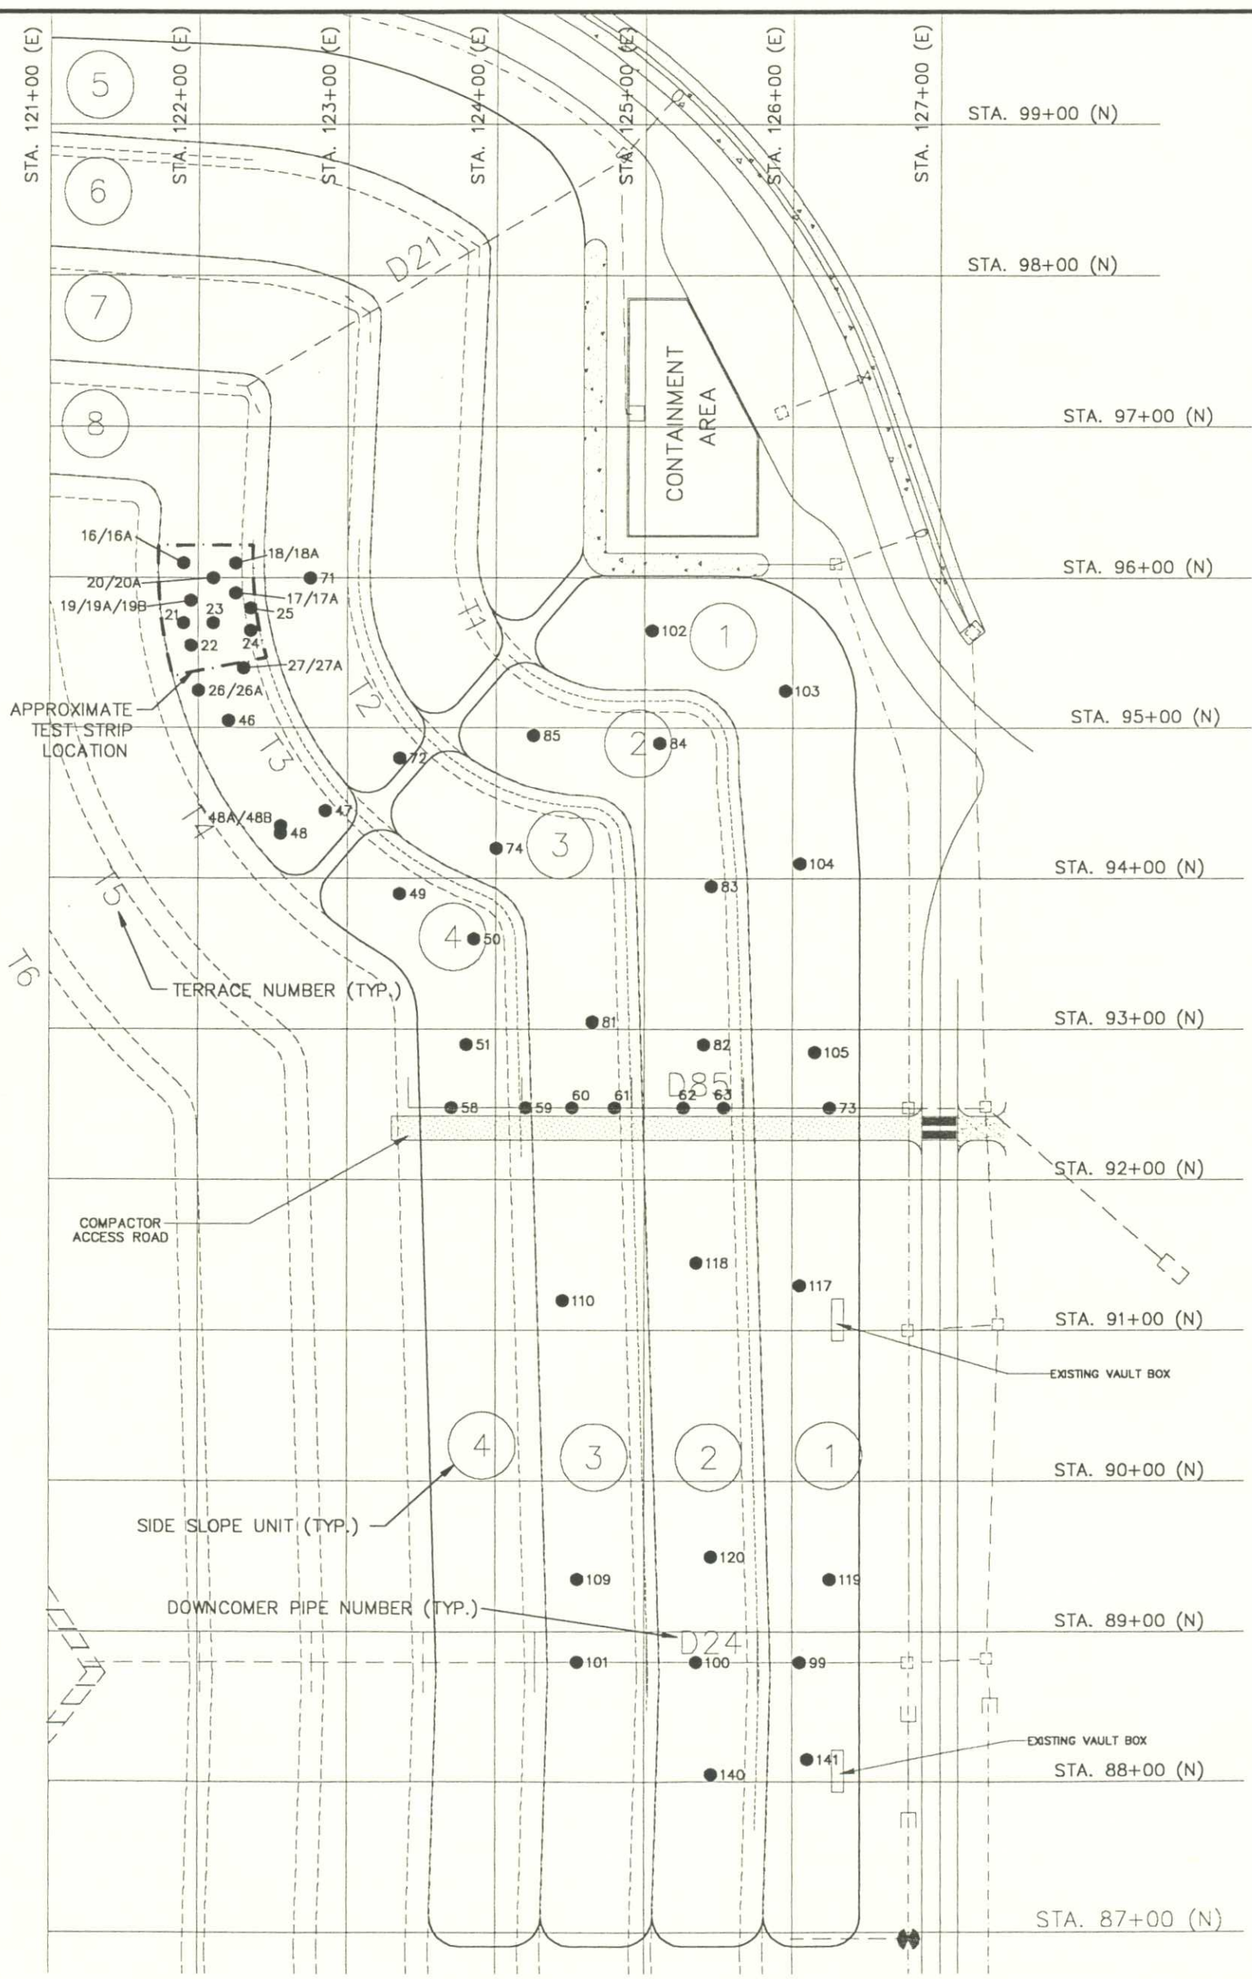

0 50' 100'

GRAPHIC SCALE

LEGEND

●120 FIELD DENSITY TEST LOCATION (1ST LIFT)


LAW

ENGINEERING AND ENVIRONMENTAL SERVICES, INC.

CLAY LAYER

Field Density Test Locations (1st Lift)
Trail Ridge Landfill Incremental Closure
Jacksonville, Florida

DRAWN: JP	DATE: 11/19/97	SCALE: AS SHOWN
CHECKED: JAH	PROJ. NO. 40562-7-3268	APPROX.

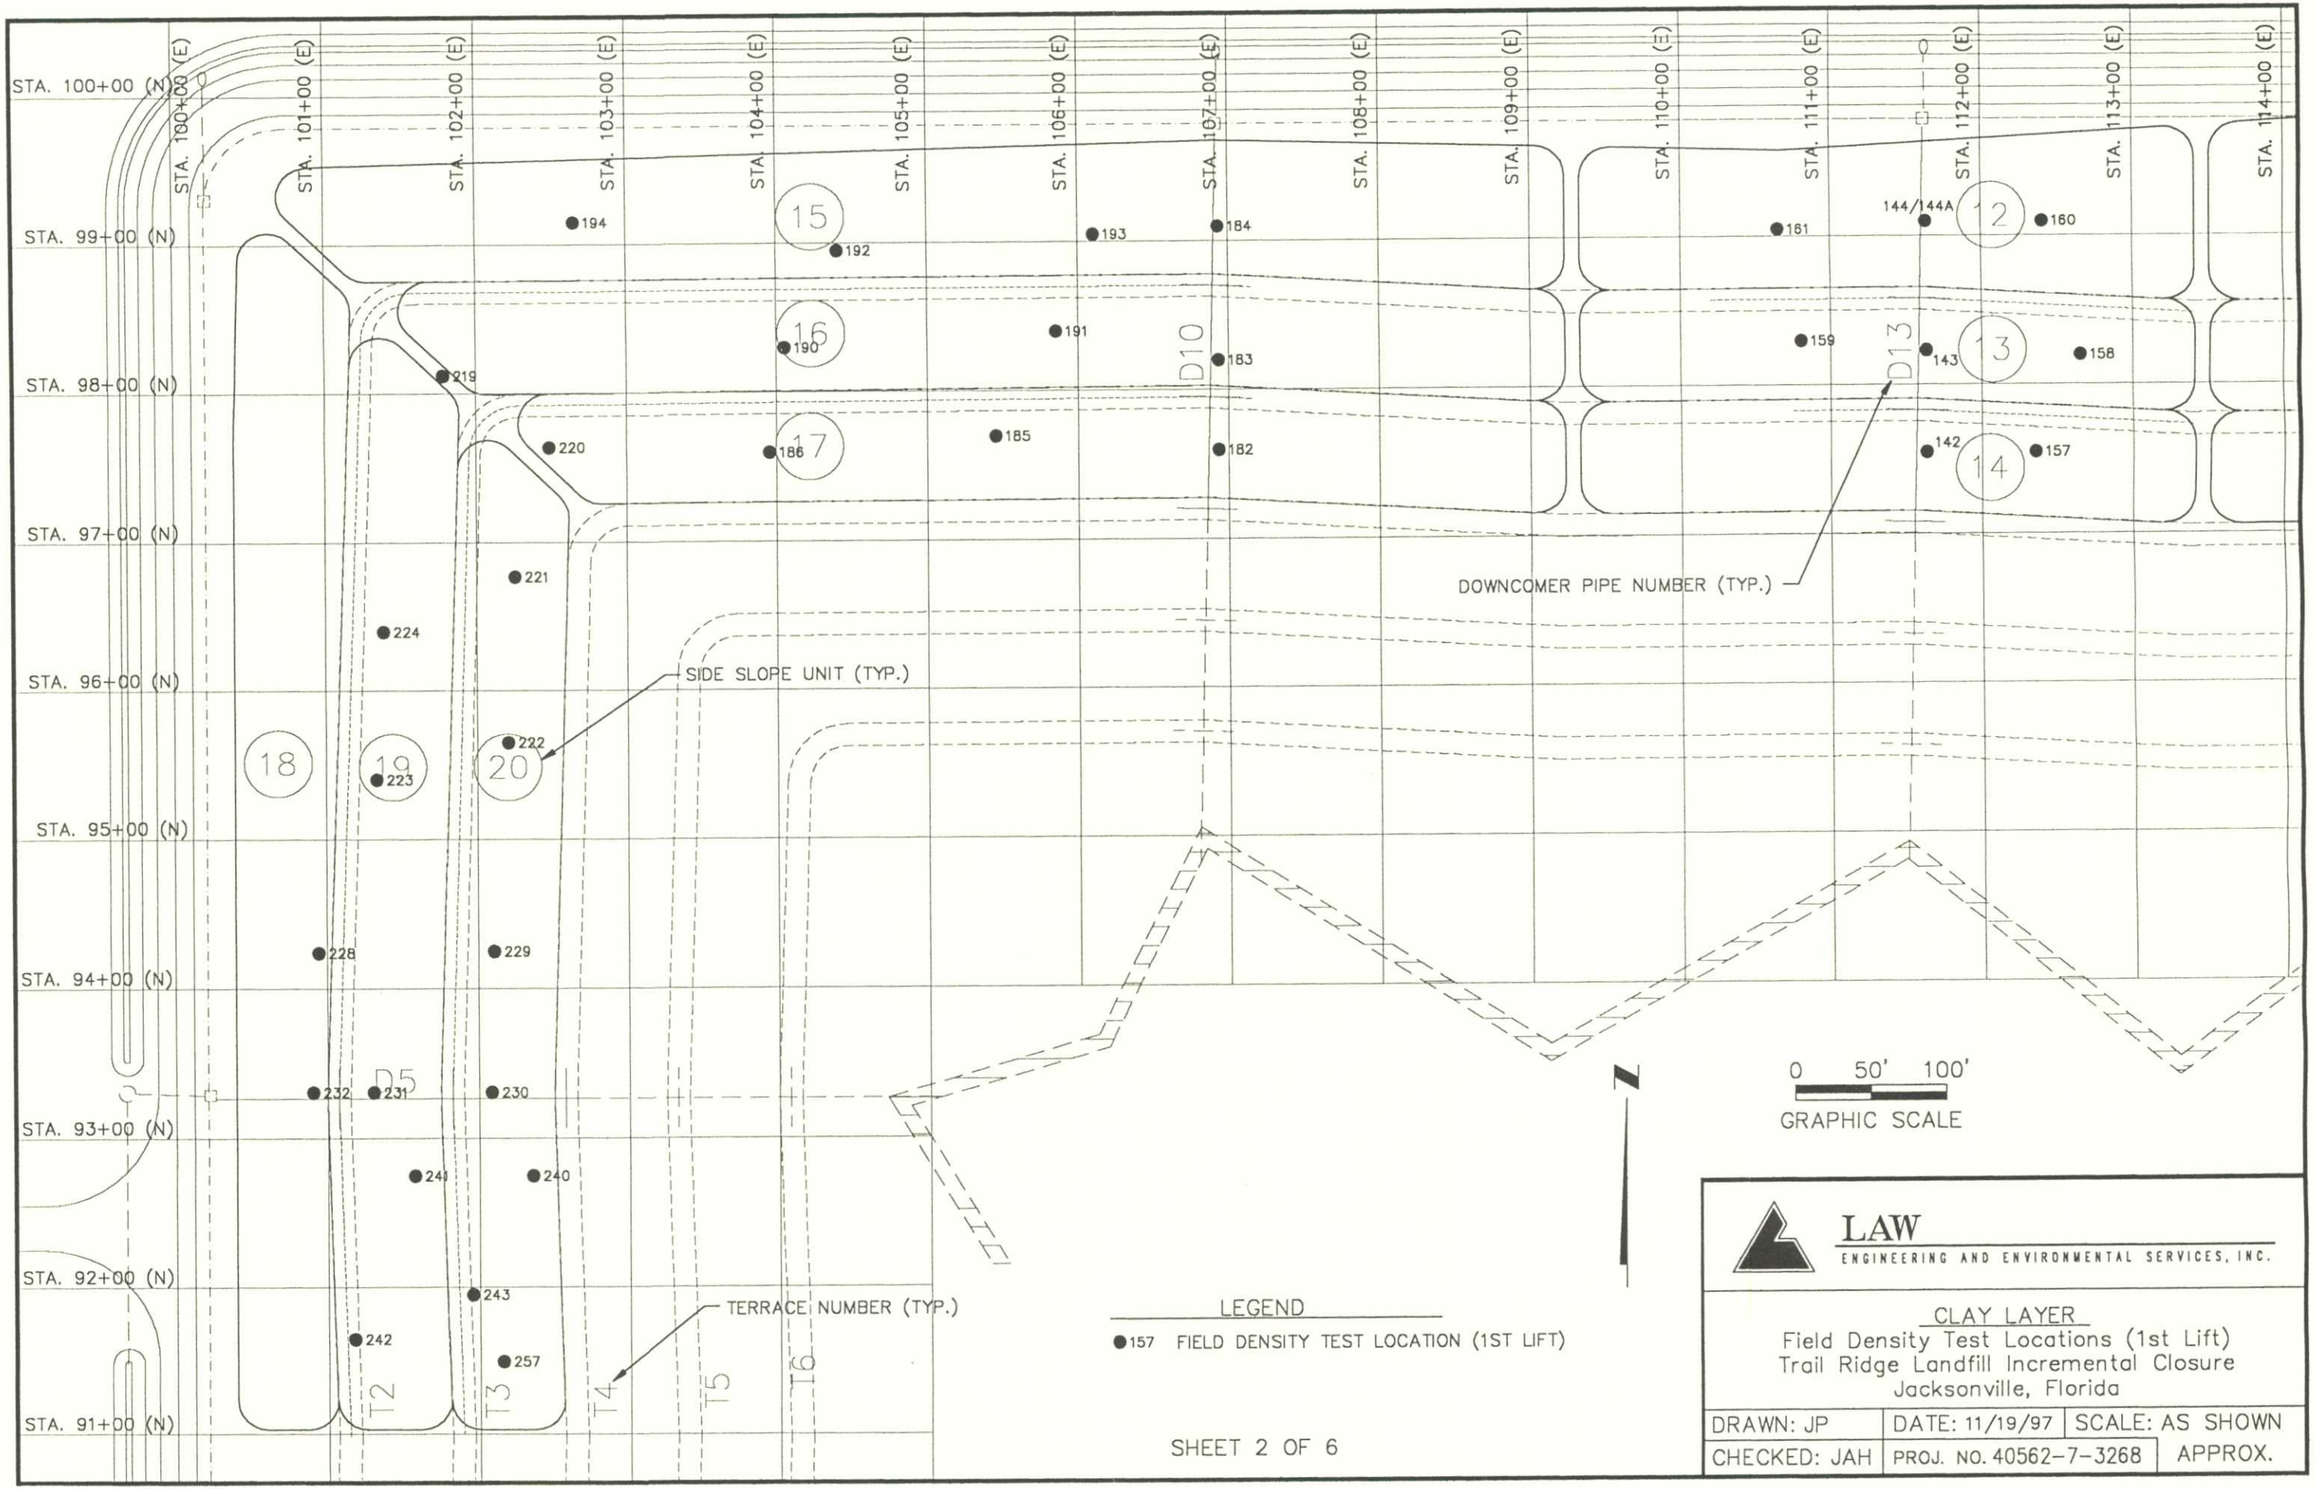

LEGEND


●157 FIELD DENSITY TEST LOCATION (1ST LIFT)

SHEET 2 OF 6

LAW
ENGINEERING AND ENVIRONMENTAL SERVICES, INC.

CLAY LAYER
Field Density Test Locations (1st Lift)
Trail Ridge Landfill Incremental Closure
Jacksonville, Florida

DRAWN: JP	DATE: 11/19/97	SCALE: AS SHOWN
CHECKED: JAH	PROJ. NO. 40562-7-3268	APPROX.

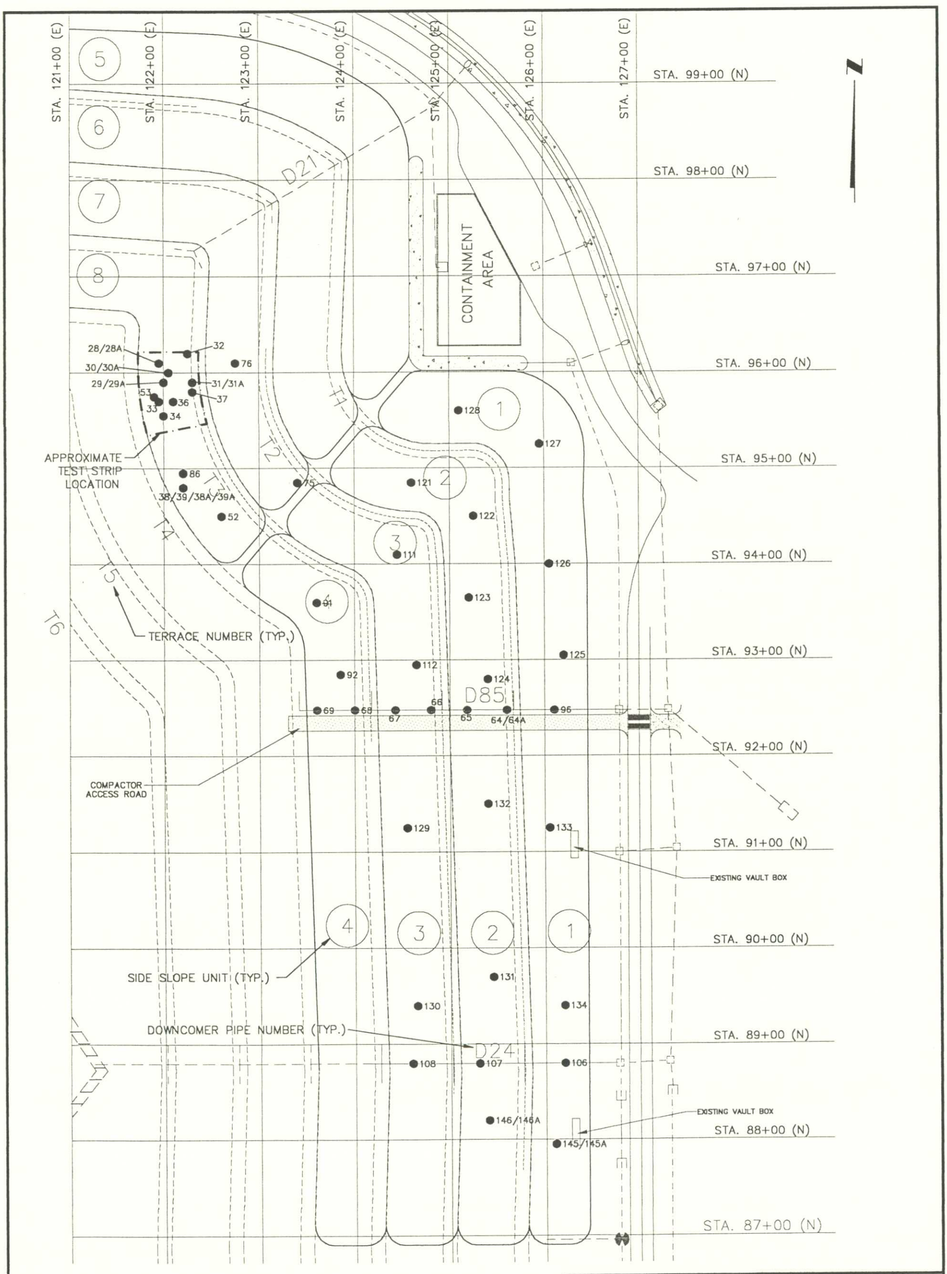

LEGEND

●130 FIELD DENSITY TEST LOCATION (2ND LIFT)

0 50' 100'

GRAPHIC SCALE

LAW


ENGINEERING AND ENVIRONMENTAL SERVICES, INC.

CLAY LAYER

Field Density Test Locations (2nd Lift)
Trail Ridge Landfill Incremental Closure
Jacksonville, Florida

DRAWN: JP	DATE: 11/19/97	SCALE: AS SHOWN
CHECKED: JAH	PROJ. NO. 40562-7-3268	APPROX.

SHEET 3 OF 6

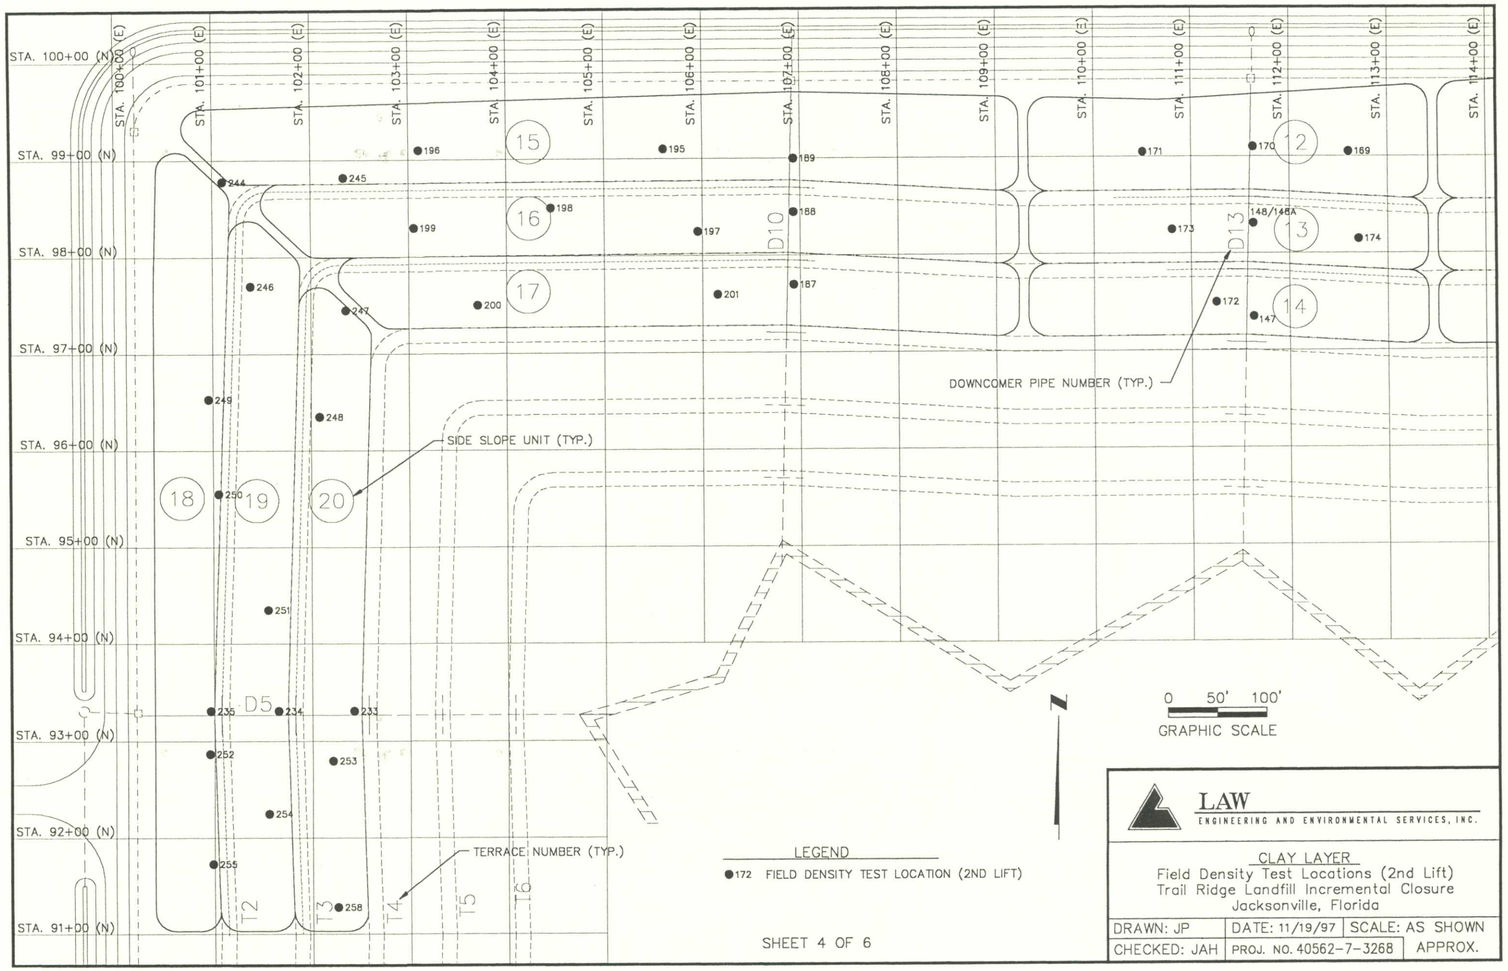


SHEET 4 OF 6

LAW
ENGINEERING AND ENVIRONMENTAL SERVICES, INC.

CLAY LAYER
Field Density Test Locations (2nd Lift)
Trail Ridge Landfill Incremental Closure
Jacksonville, Florida

DRAWN: JP	DATE: 11/19/97	SCALE: AS SHOWN
CHECKED: JAH	PROJ. NO. 40562-7-3268	APPROX.

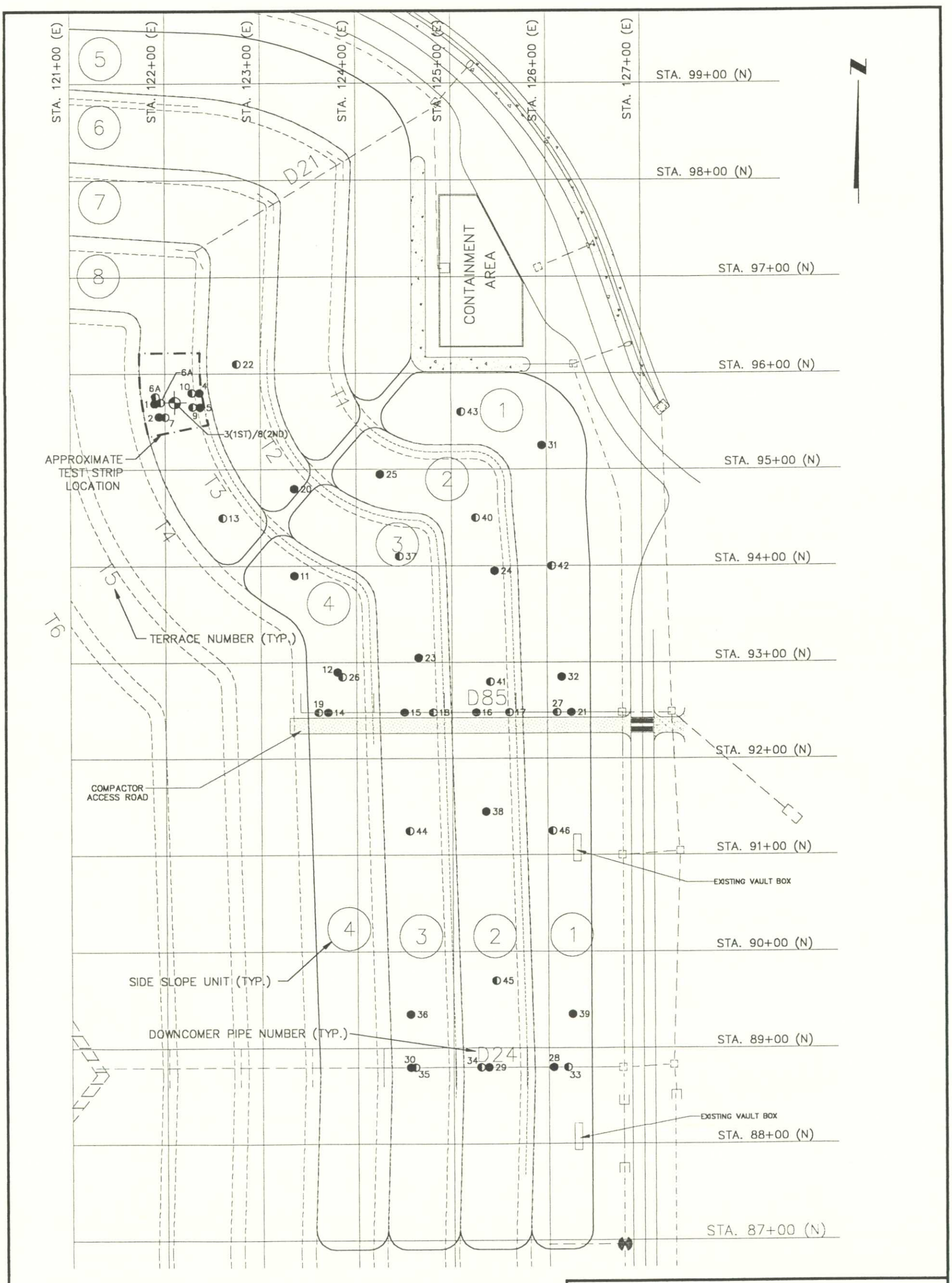

0 50' 100'

GRAPHIC SCALE

LEGEND


- ●45 PERMEABILITY TEST LOCATION (1ST LIFT)
- ◐35 PERMEABILITY TEST LOCATION (2ND LIFT)
- 3(1ST)/8(2ND) PERMEABILITY TEST LOCATION (1ST & 2ND LIFT)

SHEET 5 OF 6

LAW
ENGINEERING AND ENVIRONMENTAL SERVICES, INC.

CLAY LAYER
Permeability Test Locations
Trail Ridge Landfill Incremental Closure
Jacksonville, Florida

DRAWN: JP	DATE: 11/19/97	SCALE: AS SHOWN
CHECKED: JAH	PROJ. NO. 40562-7-3268	APPROX.

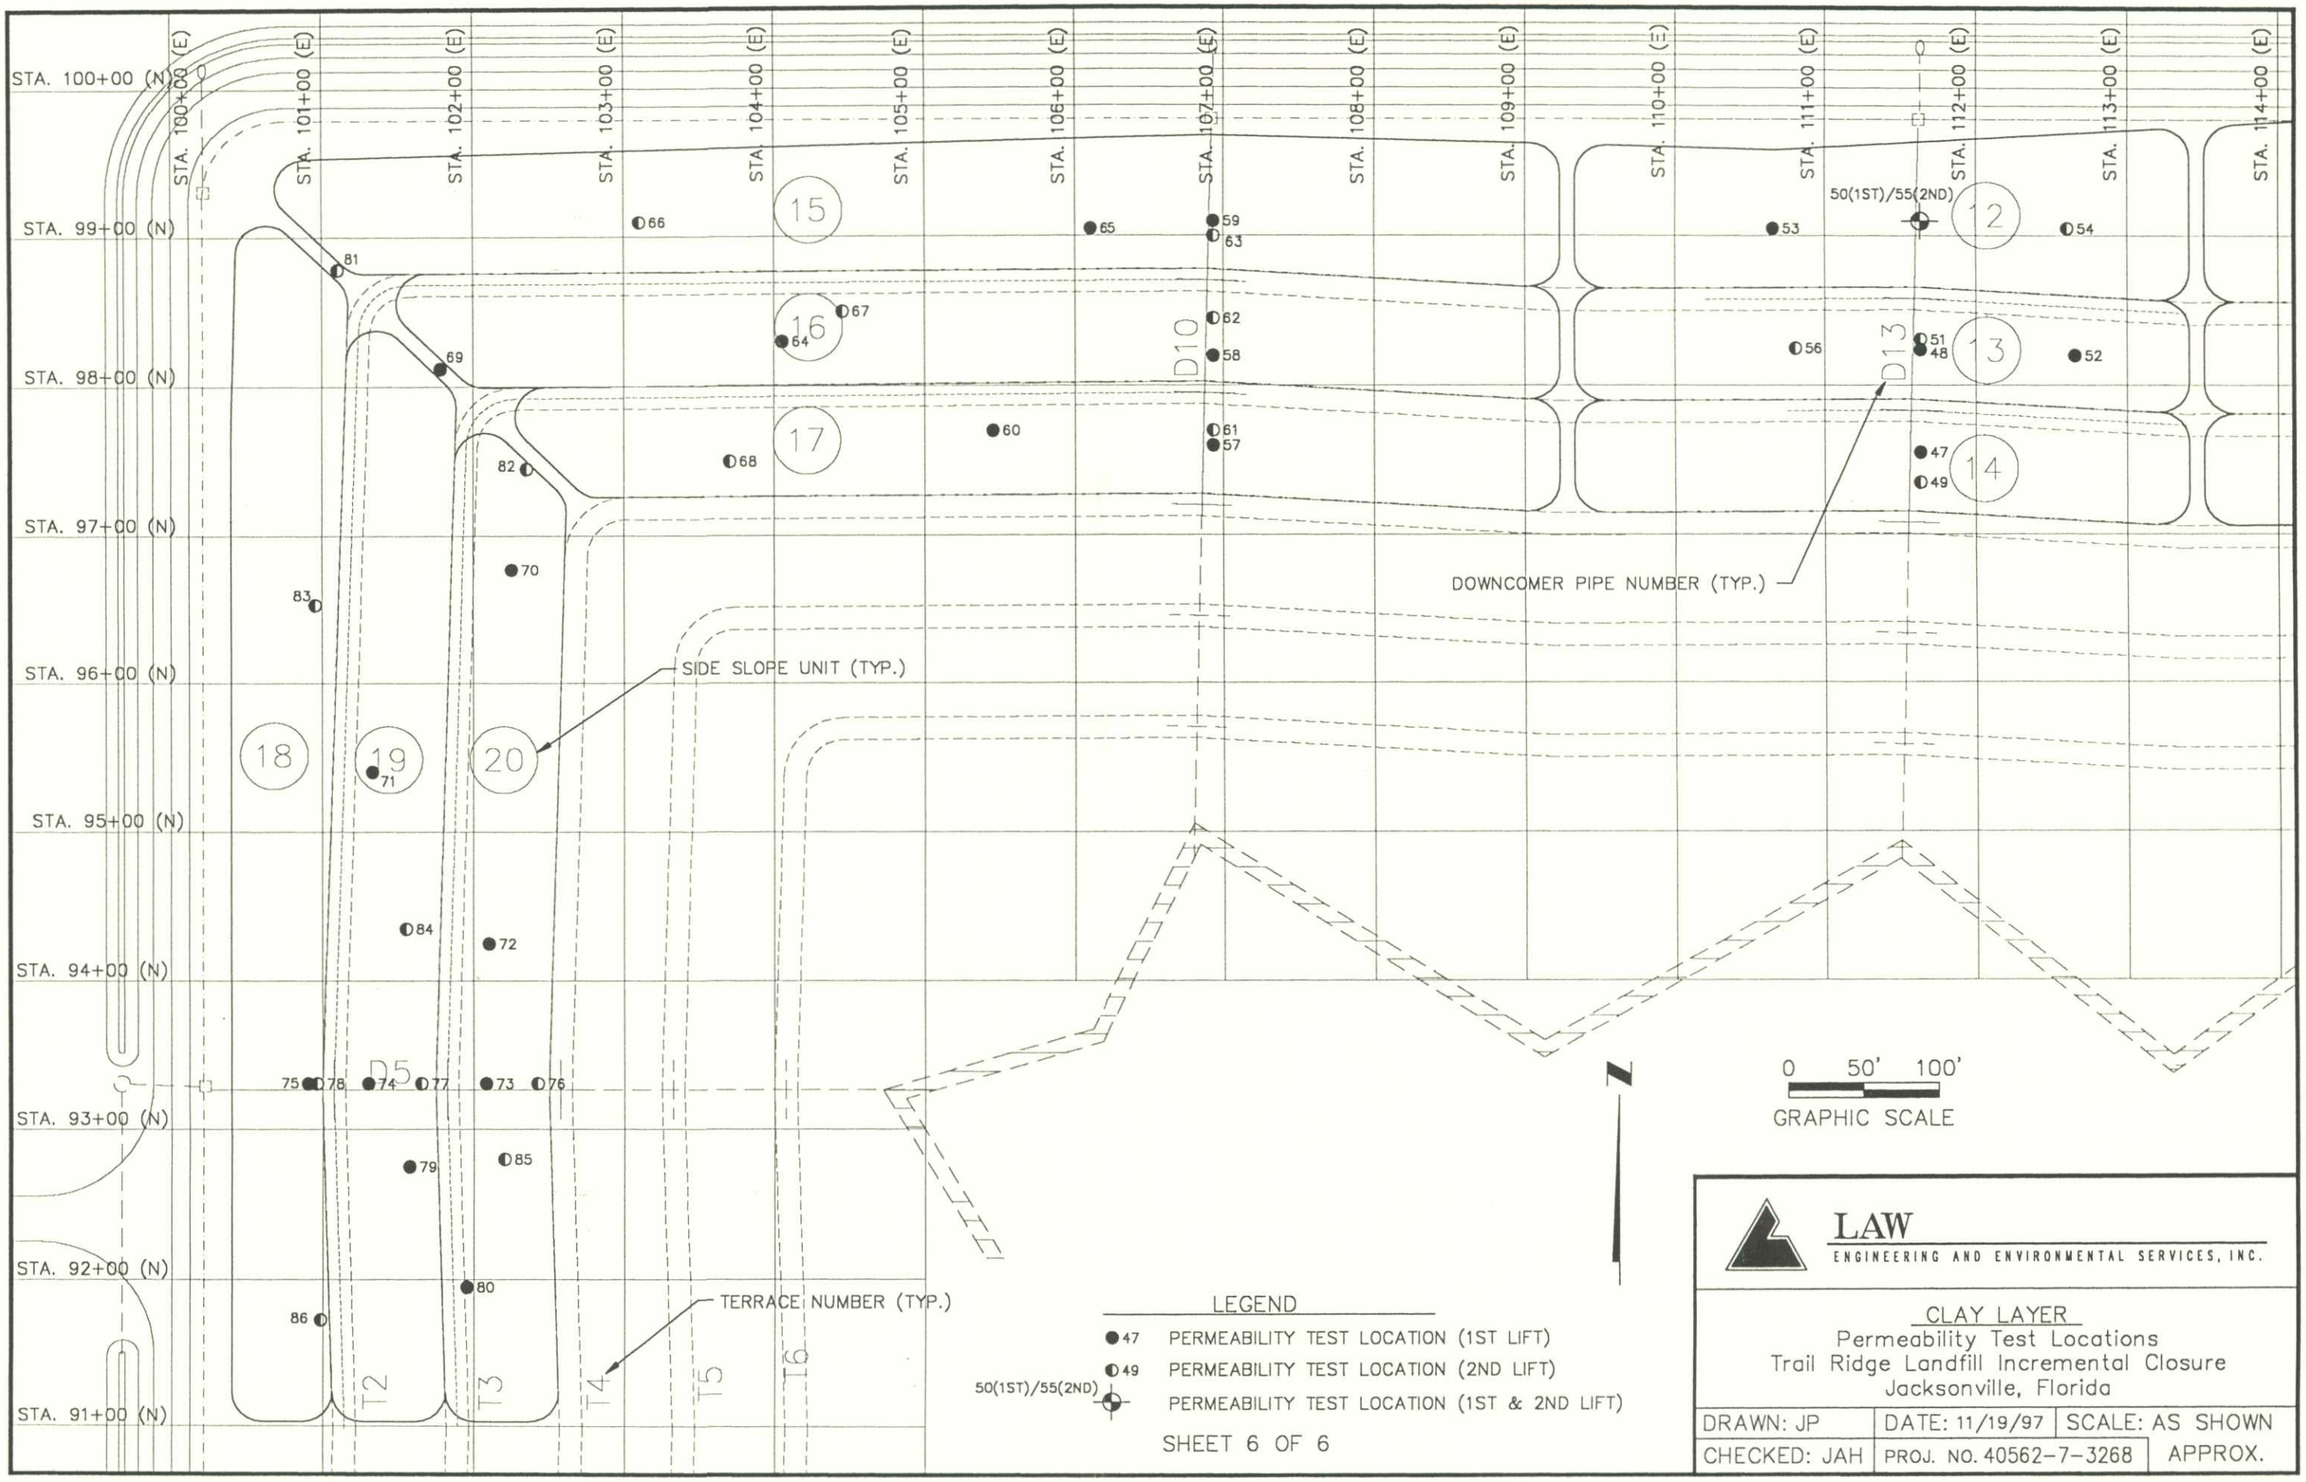


SHEET 6 OF 6

LAW
ENGINEERING AND ENVIRONMENTAL SERVICES, INC.

CLAY LAYER
Permeability Test Locations
Trail Ridge Landfill Incremental Closure
Jacksonville, Florida

DRAWN: JP	DATE: 11/19/97	SCALE: AS SHOWN
CHECKED: JAH	PROJ. NO. 40562-7-3268	APPROX.

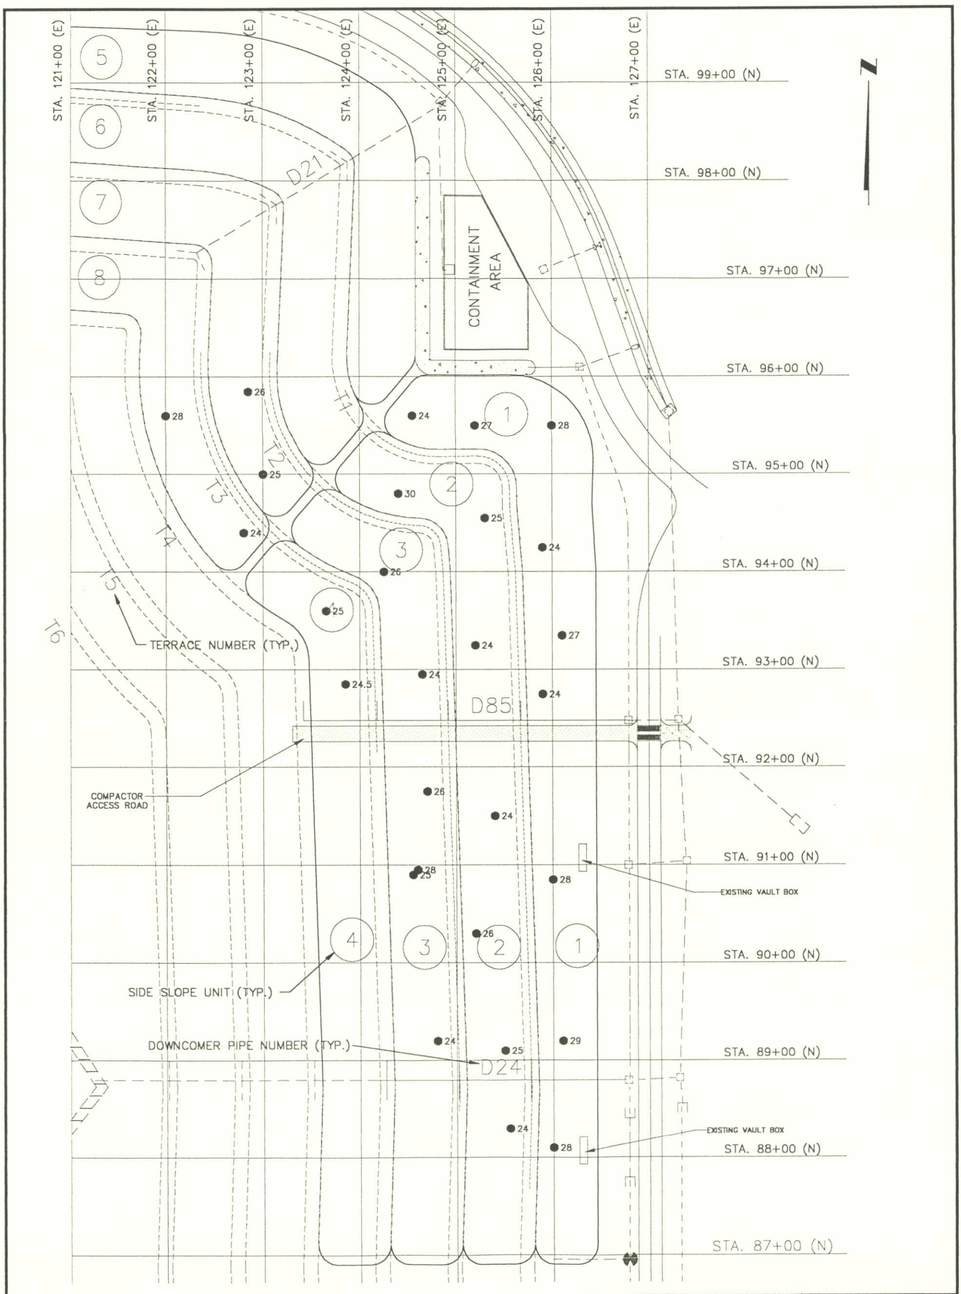

0 50' 100'
GRAPHIC SCALE

LEGEND


●24 VEGETATIVE COVER TEST LOCATION (NUMBER REPRESENTS THICKNESS IN INCHES)

SHEET 1 OF 2

LAW
ENGINEERING AND ENVIRONMENTAL SERVICES, INC.

TOP SOIL LAYER
Top Soil Test Locations
Trail Ridge Landfill Incremental Closure
Jacksonville, Florida

DRAWN: JP	DATE: 11/19/97	SCALE: AS SHOWN
CHECKED: JAH	PROJ. NO. 40562-7-3268	APPROX.

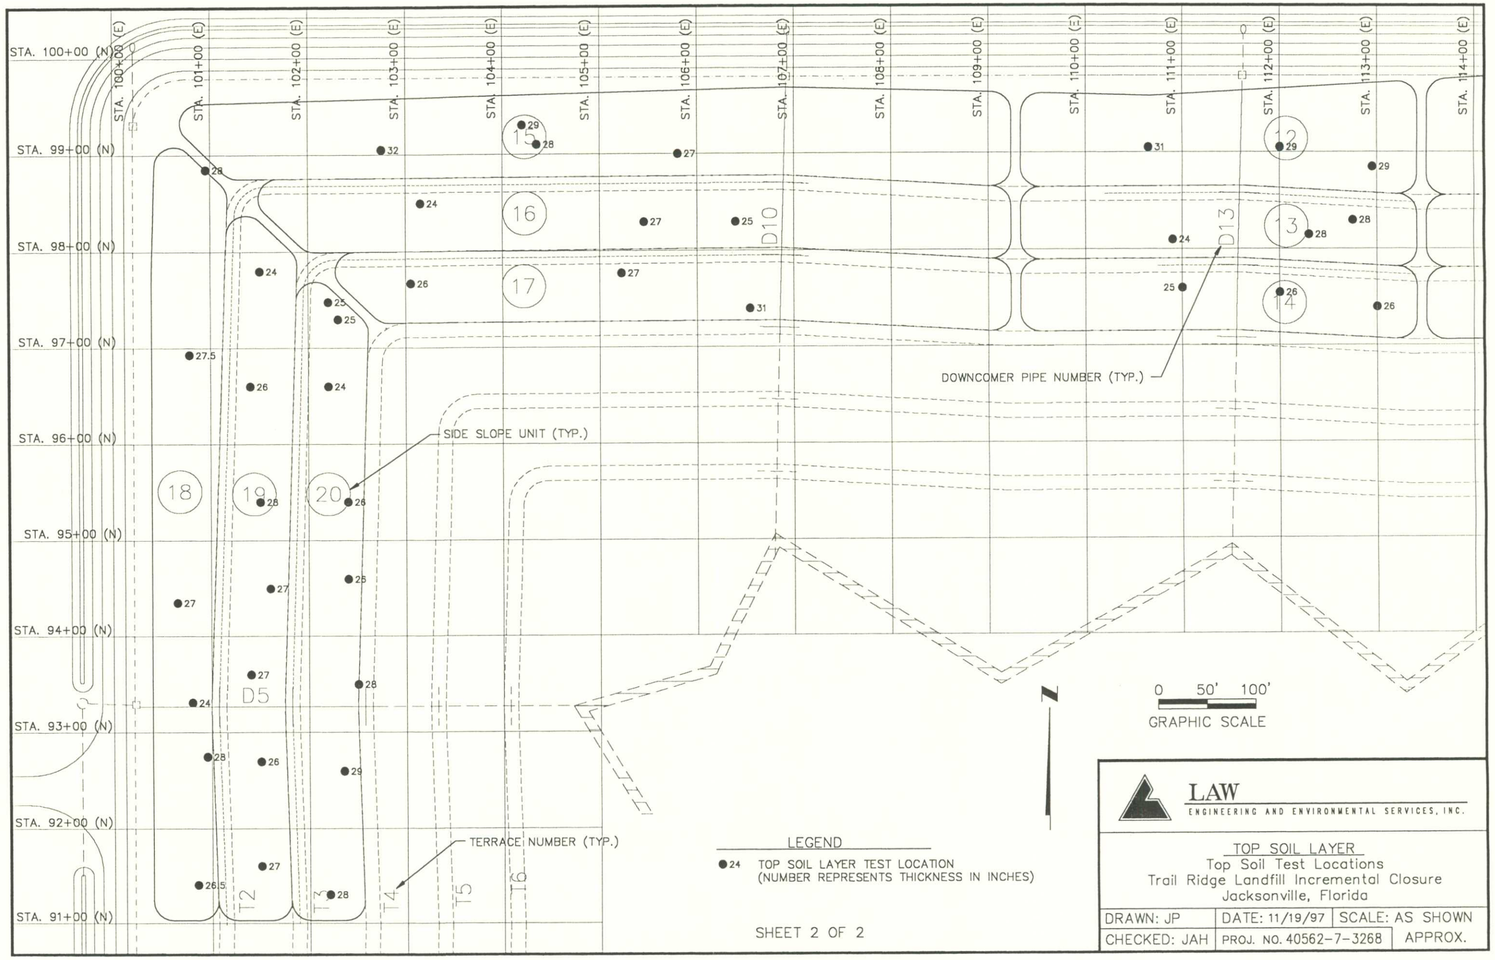

SHEET 2 OF 2

LAW
ENGINEERING AND ENVIRONMENTAL SERVICES, INC.

TOP SOIL LAYER
Top Soil Test Locations
Trail Ridge Landfill Incremental Closure
Jacksonville, Florida

DRAWN: JP	DATE: 11/19/97	SCALE: AS SHOWN
CHECKED: JAH	PROJ. NO. 40562-7-3268	APPROX.