

WELL COMPLETION LOG

Water Mgmt. Dist.:
Permit Number:

Work Order: 419036
Type of Well: Gas Well
Well Number: GP 14R
Method Used: Sonic
Borehole Diaz. 6"

Site Information:

Name: Dade City Landfill
Address: 41111 Enterprise Rd
C,S,Z: Dade City, FL
S/T/R:


Client / Consultant Information

Consultant: Locklear & Assoc.
Field Rep: Walker Wrenn

Well Diameter	Well Type	Well Depth	Screen Length	Casing Length	Bags Grout	Sand Bags/Weight	Filter Type	Well Seal
1"	PVC	45'	40;	5'	0.25	21 / 50 lbs.	20/30	30/65
40 ←	Schedule	Slot Size: →	0.01		2'	← Feet →	42'	1'

Surface Completion

4" AGP

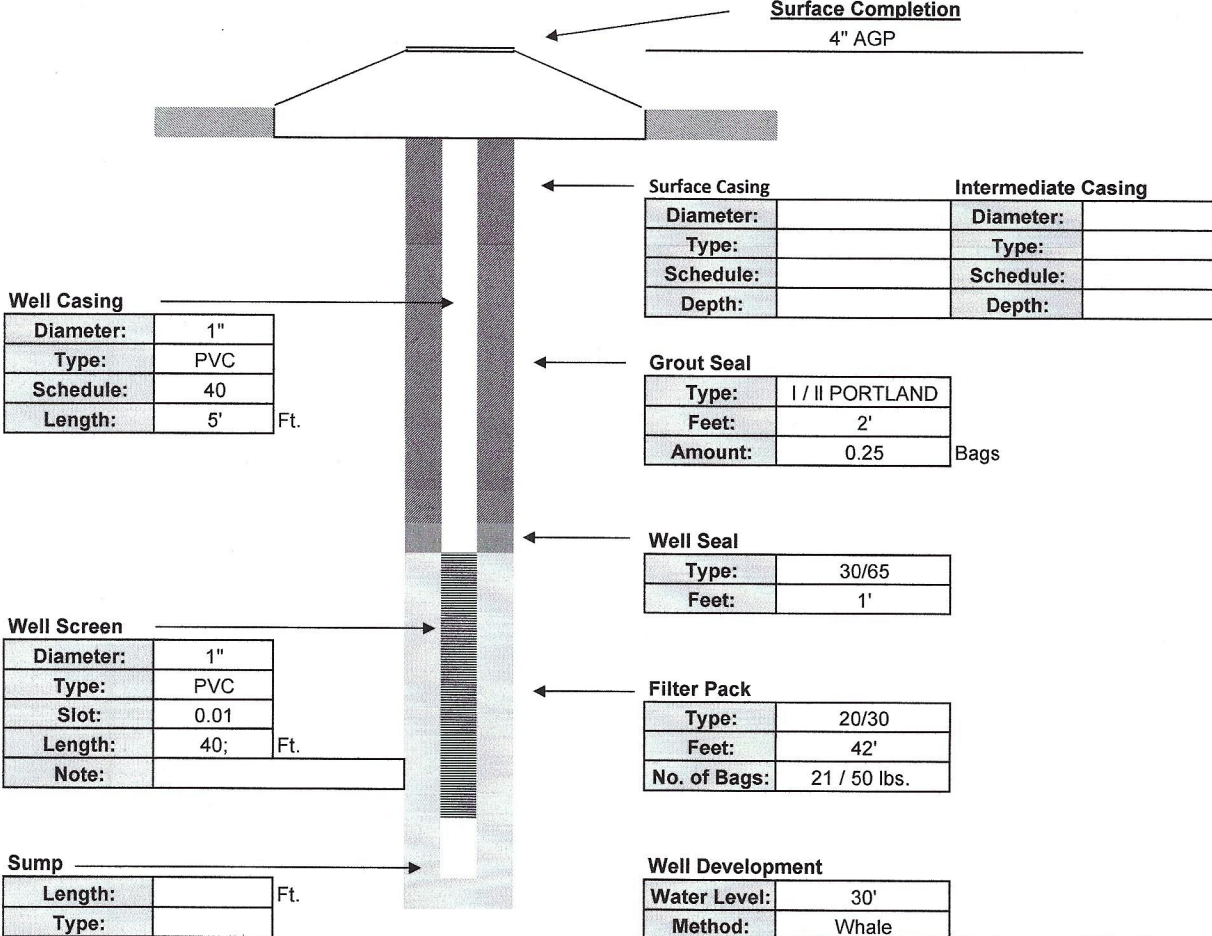

Well Casing

Diameter:	1"
Type:	PVC
Schedule:	40
Length:	5' Ft.

Surface Casing

Diameter:	
Type:	
Schedule:	
Depth:	

Intermediate Casing

Diameter:	
Type:	
Schedule:	
Depth:	

Grout Seal

Type:	I / II PORTLAND
Feet:	2'
Amount:	0.25 Bags

Well Seal

Type:	30/65
Feet:	1'

Well Screen

Diameter:	1"
Type:	PVC
Slot:	0.01
Length:	40; Ft.
Note:	

Filter Pack

Type:	20/30
Feet:	42'
No. of Bags:	21 / 50 lbs.

Sump

Length:		Ft.
Type:		

Well Development

Water Level:	30'		
Method:	Whale		
Start:	Cloudy	Finish:	Clear
Time:	.5 Hr		
GPM:	2		

Contractor Information

Contractor #:	9311
Completion:	4/30/2019
Driller:	Dave Longino
Lead Hand:	Jared Link
3rd Man:	Gama Rivera
Drill Rig:	SR 6

Company:	Drillpro LLC d/b/a Groundwater Protection
Address:	2300 Silver Star Road
C,S,Z:	Orlando, Florida 32804-3310
Phone/FAX:	(407) 426-7885 / (407) 426-7586