

Smith, George

From: SWD_Solid_Waste_Permitting
Sent: Wednesday, June 29, 2022 9:57 AM
To: SWD_Waste
Subject: FW: DEP MAIL: US 27 Tires (101295) May 2022 Inspection Report & IC Letter
Attachments: picture.jpeg; site plan.JPG

Please feel free to contact me with any questions or concerns.

Thanks, Melissa

From: Abdel Bell <us27tires@gmail.com>
Sent: Friday, June 24, 2022 12:34 PM
To: SWD_Clerical <SWD_Clerical@dep.state.fl.us>
Cc: Ammon, Pamela <Pamela.Ammon@FloridaDEP.gov>; SWD_Solid_Waste_Permitting <SWD_Solid_Waste_Permitting@floridadep.gov>; Westervelt, Hannah <Hannah.Westervelt@FloridaDEP.gov>; Mandalou, Taylor <Taylor.Mandalou@FloridaDEP.gov>; Stitt, Emily <Emily.Stitt@FloridaDEP.gov>
Subject: Re: DEP MAIL: US 27 Tires (101295) May 2022 Inspection Report & IC Letter

EXTERNAL MESSAGE

This email originated outside of DEP. Please use caution when opening attachments, clicking links, or responding to this email.

To Whom It May Concern,
Please find the attached requested proof of the 8-foot setback, along with a site plan.
Thank you,
US 27 Tires LLC

On Wed, Jun 8, 2022 at 3:49 PM SWD_Clerical <SWD_Clerical@dep.state.fl.us> wrote:

Greetings,

The Department of Environmental Protection is using electronic correspondence rather than paper mail to deliver documents faster while reducing costs and waste. Please click on the link below to access the above referenced document in OCULUS, the Department of Environmental Protection's electronic document management system.

[https://depedms.dep.state.fl.us:443/Oculus/servlet/shell?command=getEntity&\[guid=8.343820.1\]&\[profile=Discovery Compliance\]](https://depedms.dep.state.fl.us:443/Oculus/servlet/shell?command=getEntity&[guid=8.343820.1]&[profile=Discovery Compliance])

To access the documents in OCULUS:

1. Click on the link to open OCULUS at the Login screen.
2. Click on PUBLIC OCULUS login to view the search results screen.
3. Click the arrow button next to *view* in the Operations drop-down menu to open and view the document in its native format. Most OCULUS documents are in .pdf format. Acrobat Reader is required to read the document. The free reader can be downloaded from

<http://www.adobe.com/products/reader.html>.


If you are interested in reviewing documents from the Department's Information Portal, you can access the portal at <http://webapps.dep.state.fl.us/DepNexus/public/search-portal>.

Thank you for your attention to this matter.

FL. Department of Environmental Protection


Southwest District Office

PLEASE NOTE: Florida has a very broad public records law. Electronic communications regarding state business are public records available upon request. Your e-mail communications may therefore be subject to public disclosure.

 

--
US 27 Tires, LLC
29612 Highway 27
Dundee, FL 33838
863-248-2911



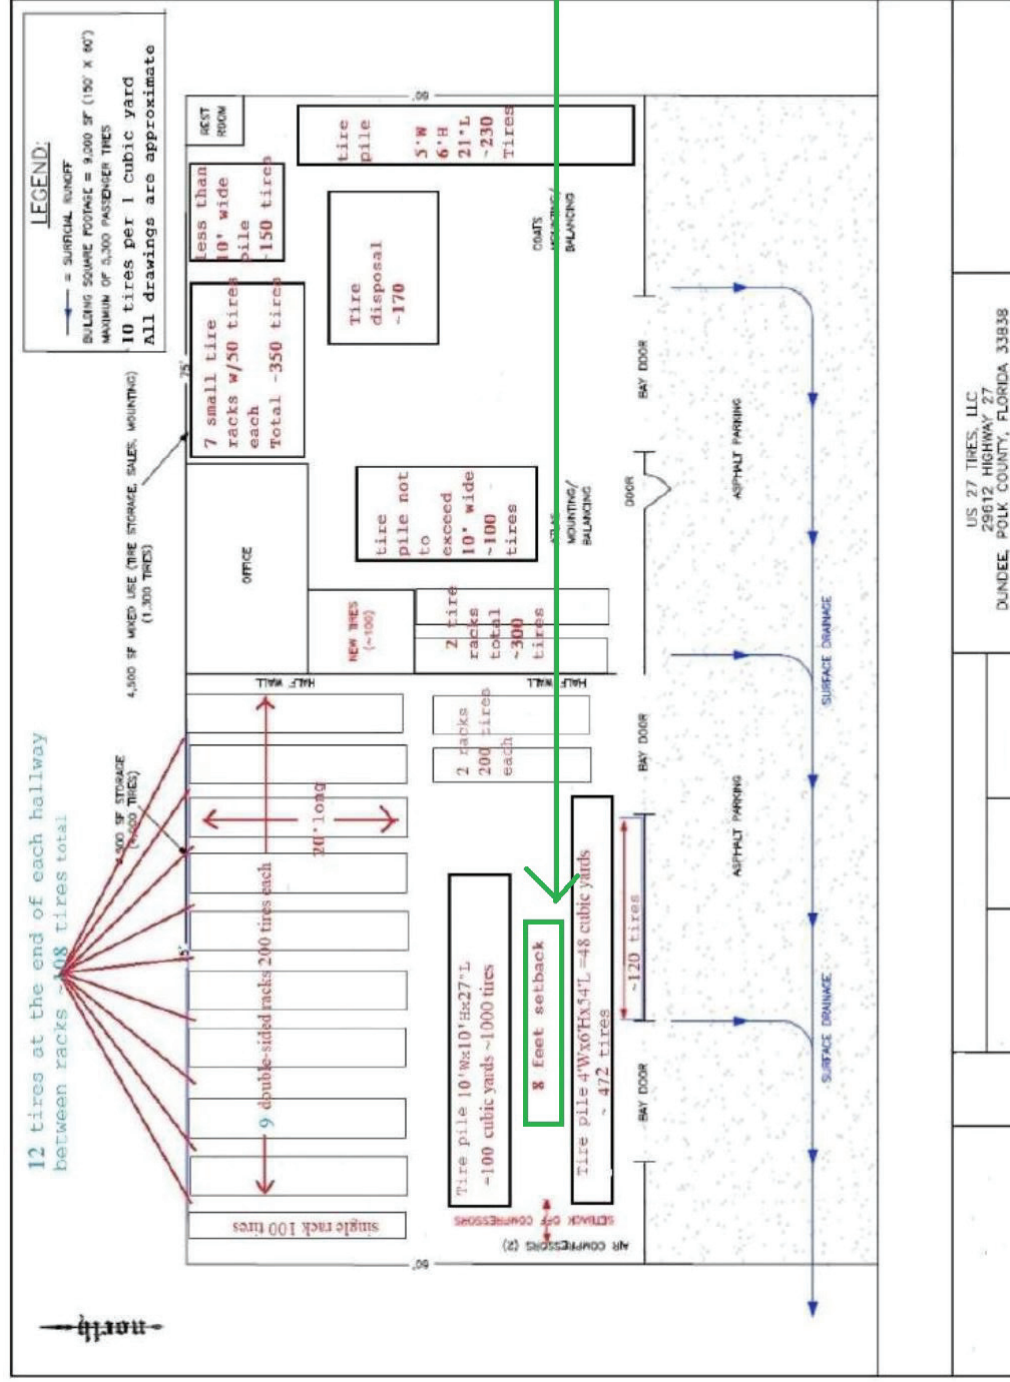

**This is where
the 8-foot set
back is in the
site plan.
Please see
attached
photo**