

From: [Abdel Bell](#)
To: [Weaver, Emily](#)
Subject: Re: FDEP Inspection Follow-Up US 27 Tires (WACS 101295)
Date: Monday, June 19, 2023 11:30:54 PM
Attachments: [image002.png](#)
[image003.png](#)
[image004.png](#)
[PERMIT.pdf](#)

EXTERNAL MESSAGE

This email originated outside of DEP. Please use caution when opening attachments, clicking links, or responding to this email.

Good morning Emily,

Please find the requested permit and a picture of the 8-foot setback attached. By the way, the permit is the same one displayed on the premises, and you took a picture of it. The expiration date is December 31.

If you have any questions, please email me.

Thank you,

Abdel

On Fri, Jun 16, 2023 at 1:26 PM Weaver, Emily <Emily.Weaver@floridadep.gov> wrote:


Good afternoon,

I was a pleasure meeting with you earlier this week. As we discussed onsite, I am reaching out as a follow-up to our inspection.

During the inspection two areas of concern were noted. Please review them below and provide a response so that your corrective actions can be added within the inspection report.

1. At the time of inspection, waste tire piles within the southwest side of the building were observed as not being in compliance with the permitted site plan. Please restore the two piles and 8-foot setback. Once completed please provide the Department with photo documentation within 7 days of this email (no later than 6/23/2023).



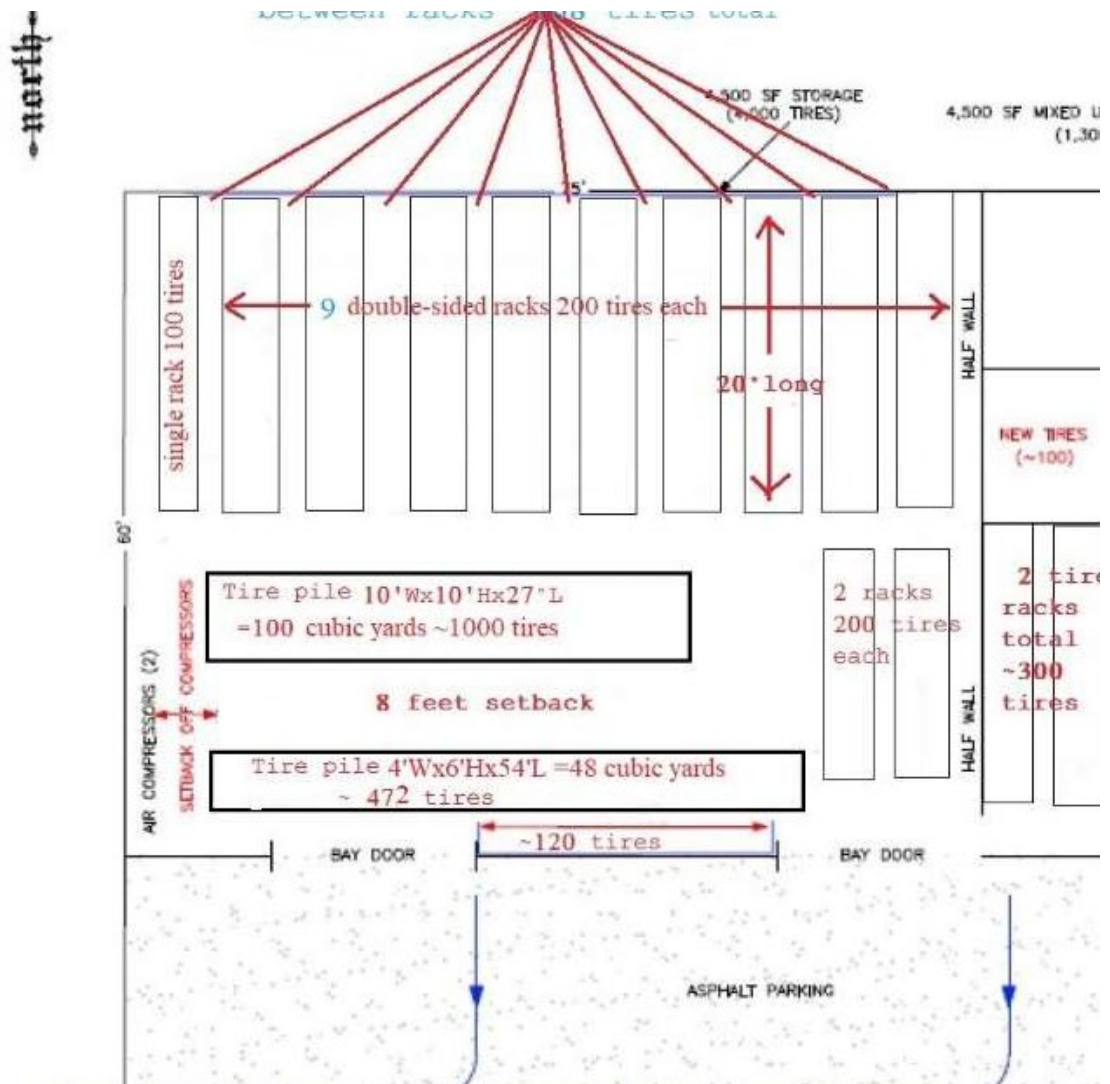

2. During the inspection, a file review was conducted. Department staff requested a copy of the current permit; however, the facility only had an older version of the file able to be provided. I have attached the most recent permit modification that should be kept onsite (either physically or digitally). In the future, please ensure that the most recent version of all reports/files detailed within the facility's Permit and Operations Plan, are kept onsite for Department review.

Please let me know if you have any questions or concerns .

Best,

Emily Weaver



Florida Department of Environmental Protection

Southwest District

Environmental Specialist II

Emily.Weaver@FloridaDEP.gov

Office: 813-470-5781



--

*US 27 Tires, LLC
29612 Highway 27
Dundee, FL 33838
863-248-2911*