


ATTACHMENT B

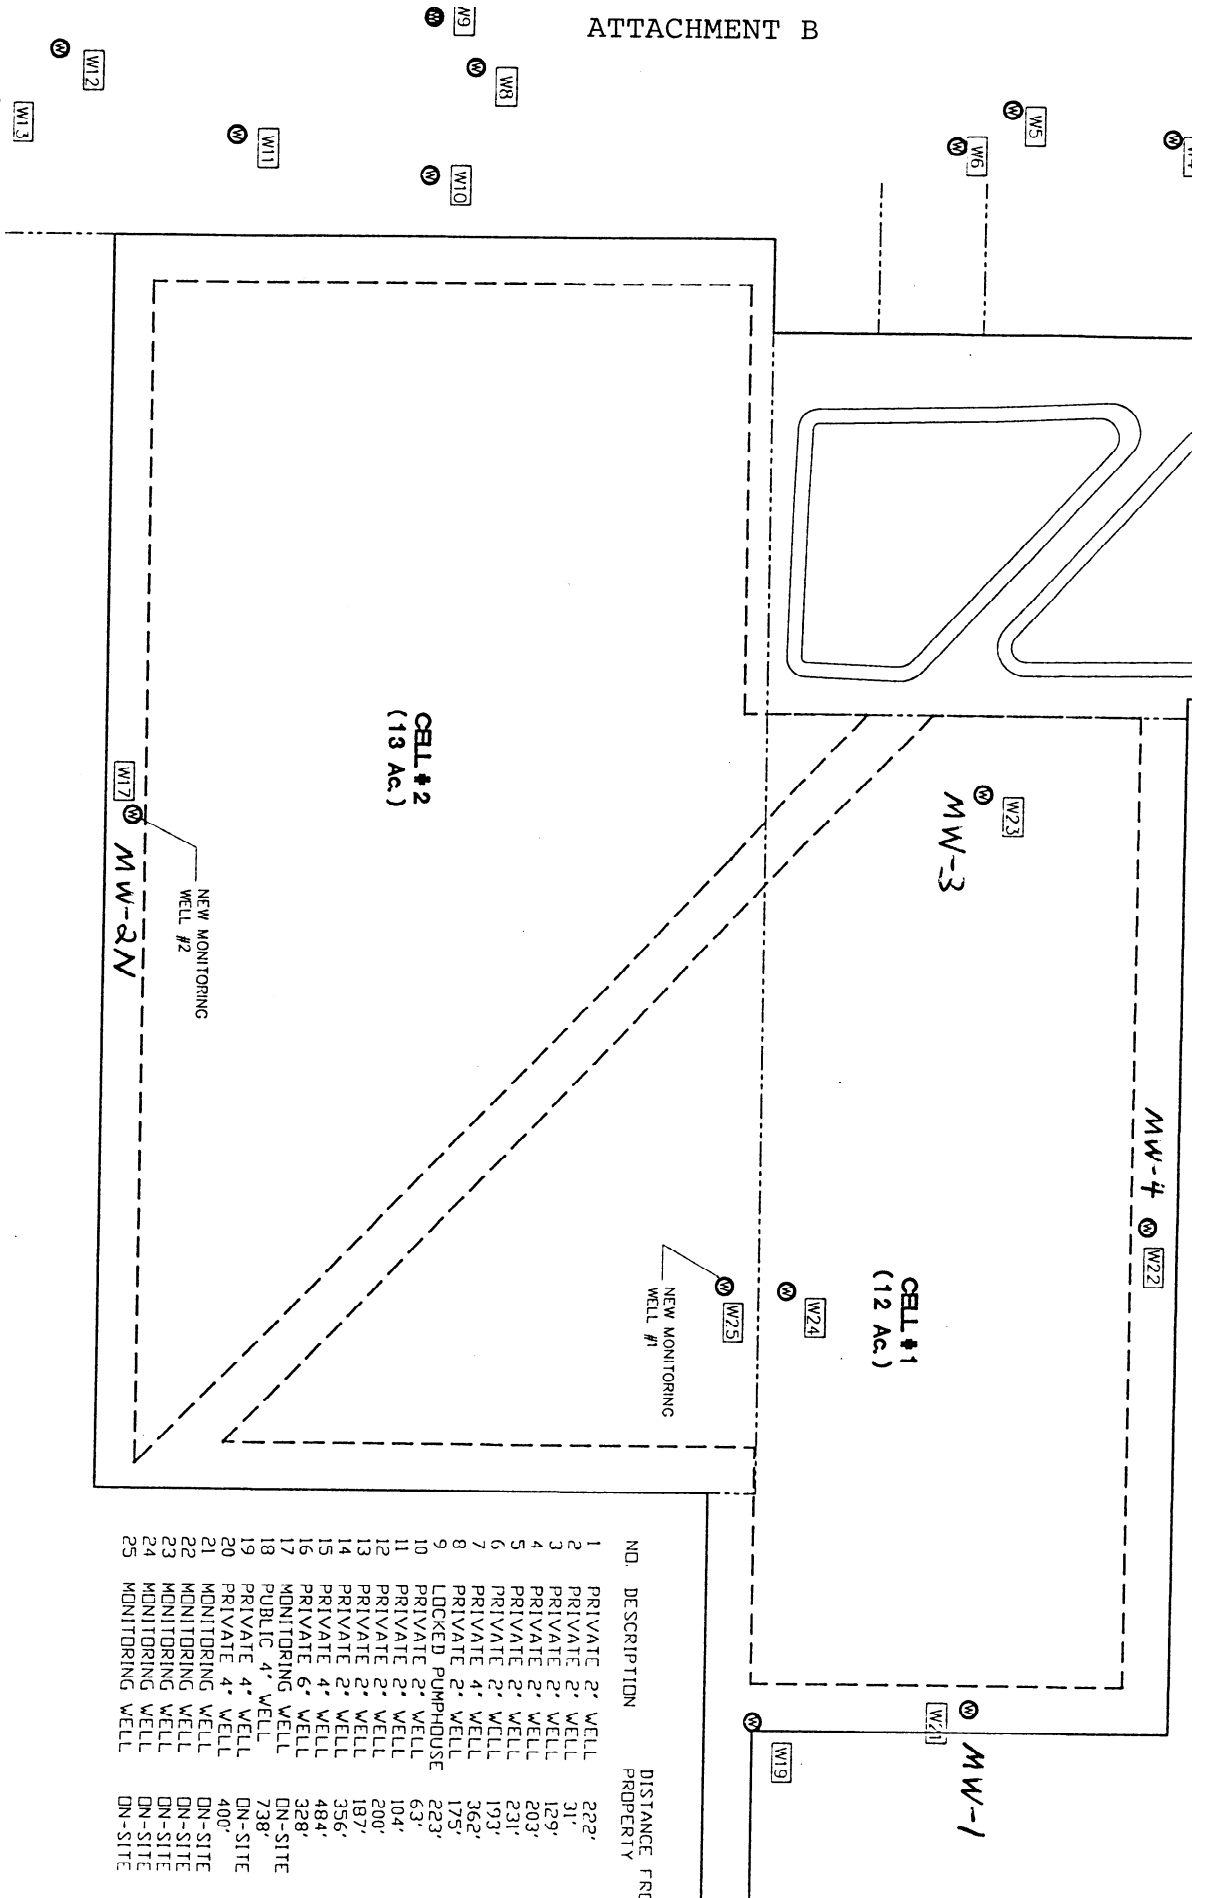

Guerra Development Corp.
Consulting Engineers

2216 E. Silver Springs Blvd.-2nd Floor
 Ocala, FL 34470. (352)-629-8060

Juan C. Guerra, P.E.
 Plat. Reg. # 0041000
 Date: 3-1-02

MONITORING WELL LOCATION MAP

OCALA RECYCLING ADDITION

REVISIONS:

NO.	DATE	BY	DESCRIPTION
1	3-1-02	JCG	OCALA RECYCLING ADDITION

DRAWN:	JCG	DATE:	4-MAR-02
SCALE:	1"=200'	DATE:	