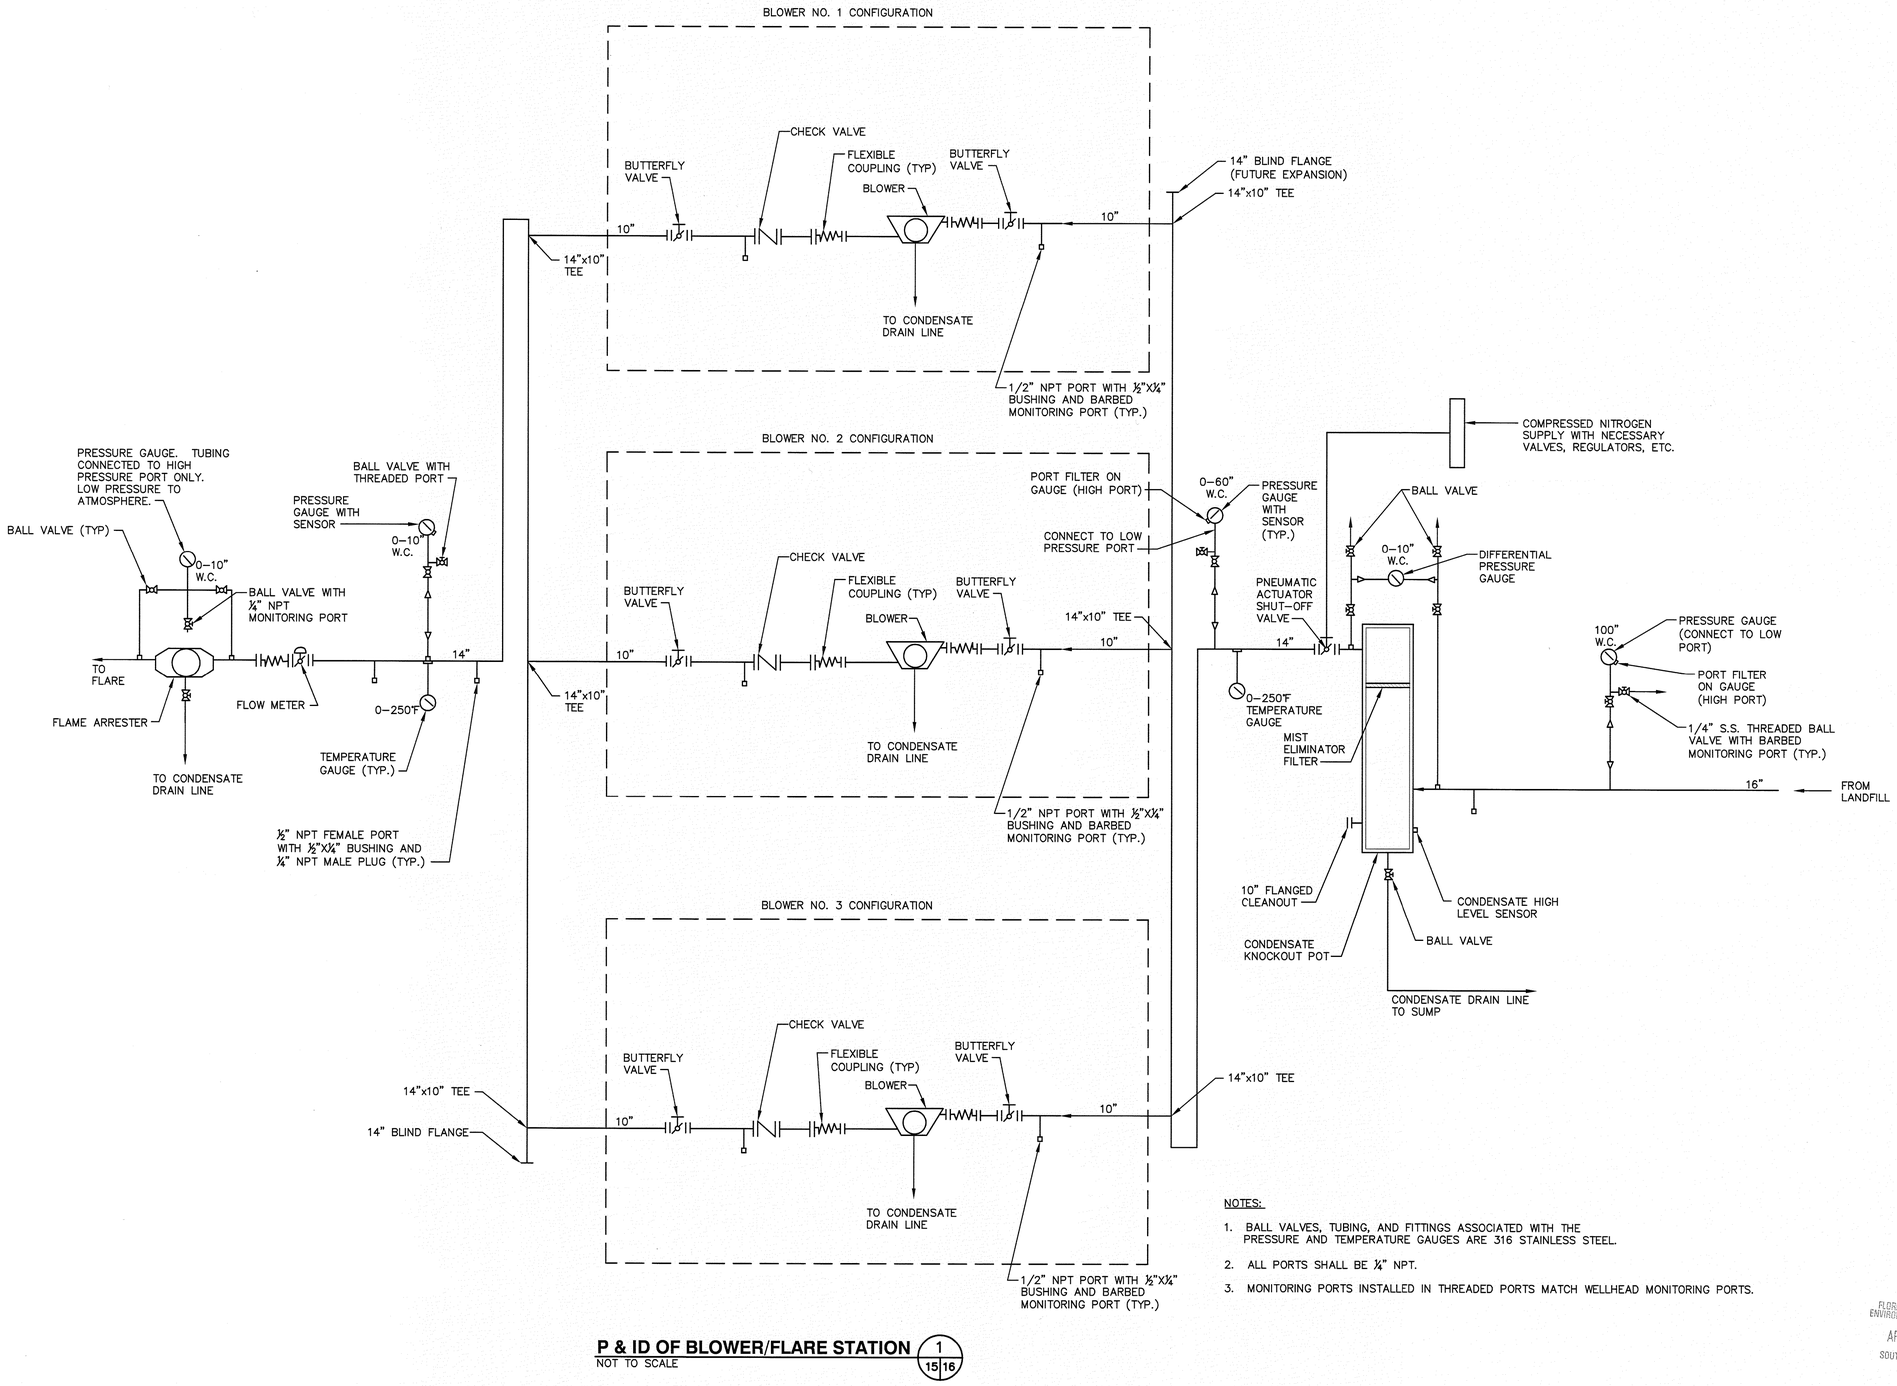

NOTES:

1. BALL VALVES, TUBING, AND FITTINGS ASSOCIATED WITH THE PRESSURE AND TEMPERATURE GAUGES ARE 316 STAINLESS STEEL.
2. ALL PORTS SHALL BE ¼" NPT.
3. MONITORING PORTS INSTALLED IN THREADED PORTS MATCH WELLHEAD MONITORING PORTS.

P & ID OF BLOWER/FLARE STATION 1/15/16

NOT TO SCALE

FLORIDA DEPARTMENT OF ENVIRONMENTAL PROTECTION
APR 16 2010
SOUTHWEST DISTRICT TAMPA

RECORD DRAWING

DATE: APRIL 15, 2010

REV	DATE	DESCRIPTION	BY
1	4/15/10	REVISED FOR THE RECORD	DRC

RAYMOND J. DEVER, P.E.
LICENSE NO. 43031

DRAWING TITLE: P & ID - BLOWER/FLARE STATION

PROJECT TITLE: SOUTHEAST COUNTY LANDFILL LANDFILL GAS COLLECTION AND CONTROL SYSTEM

CLIENT: HILLSBOROUGH COUNTY SOLID WASTE MANAGEMENT DEPARTMENT TAMPA, FLORIDA

SCS ENGINEERS
STEARNS, CONRAD AND SCHMIDT CONSULTING ENGINEERS
4041 PARK OAKS BLVD., SUITE 100, TAMPA, FL 33610
813 621-0080 FAX 813 623-6757
FLORIDA CERTIFICATE OF AUTHORIZATION NO. 00004892

PROJ. NO. 09207055.00 | DSN. BY: IMM | DWN. BY: IMM/DHP | CHK. BY: DHP | Q/A RVW BY: DRC | APP. BY: RJD

CADD FILE: 075500P&ID

DATE: OCTOBER 8, 2008

SCALE: NOT TO SCALE

DRAWING NO. 17 of 30