
  
 BARBARA L. HERRING, PSM #6134  
 DATE: 12-16-09

CONTRACTOR  
**SOUTHEAST ENVIRONMENTAL CONTRACTING, INC.**  
 5667 VAL DEL ROAD, HAHIRA, GA 31632  
 229-794-3330 FAX 229-794-3332

DESIGN ENGINEER  
**SCS ENGINEERS**  
 STEARNS, CONRAD AND SCHMIDT  
 CONSULTING ENGINEERS  
 4041 PARK OAKS BLVD., SUITE 100, TAMPA, FL 33610  
 813 821-0080 FAX 813 823-8757  
 FLORIDA CERTIFICATE OF AUTHORIZATION NO. 00004892

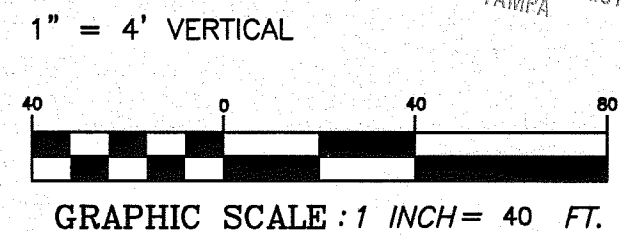

DRAWING TITLE	PIPE PROFILES	
	PROJECT TITLE	SOUTHEAST COUNTY LANDFILL LANDFILL GAS COLLECTION AND CONTROL SYSTEM PROJECT
CLIENT	HILLSBOROUGH COUNTY SOLID WASTE MANAGEMENT DEPARTMENT TAMPA, FLORIDA	
CADD FILE: PROFILE 40 SCALE	DRAWN BY:	BLH
	CHECK BY:	BLH
DATE: DECEMBER 16, 2009	DATE:	APR 16 2010
SCALE: 1" = 40'	SCALE:	1" = 40'
DRAWING NO.	8	
REV	DATE	DESCRIPTION
BY		
BARBARA L. HERRING, P.S.M. LICENSE NO. 6134		