


SECTION B B B B
SCALE: N.T.S. C-5 C-6 C-7 C-8

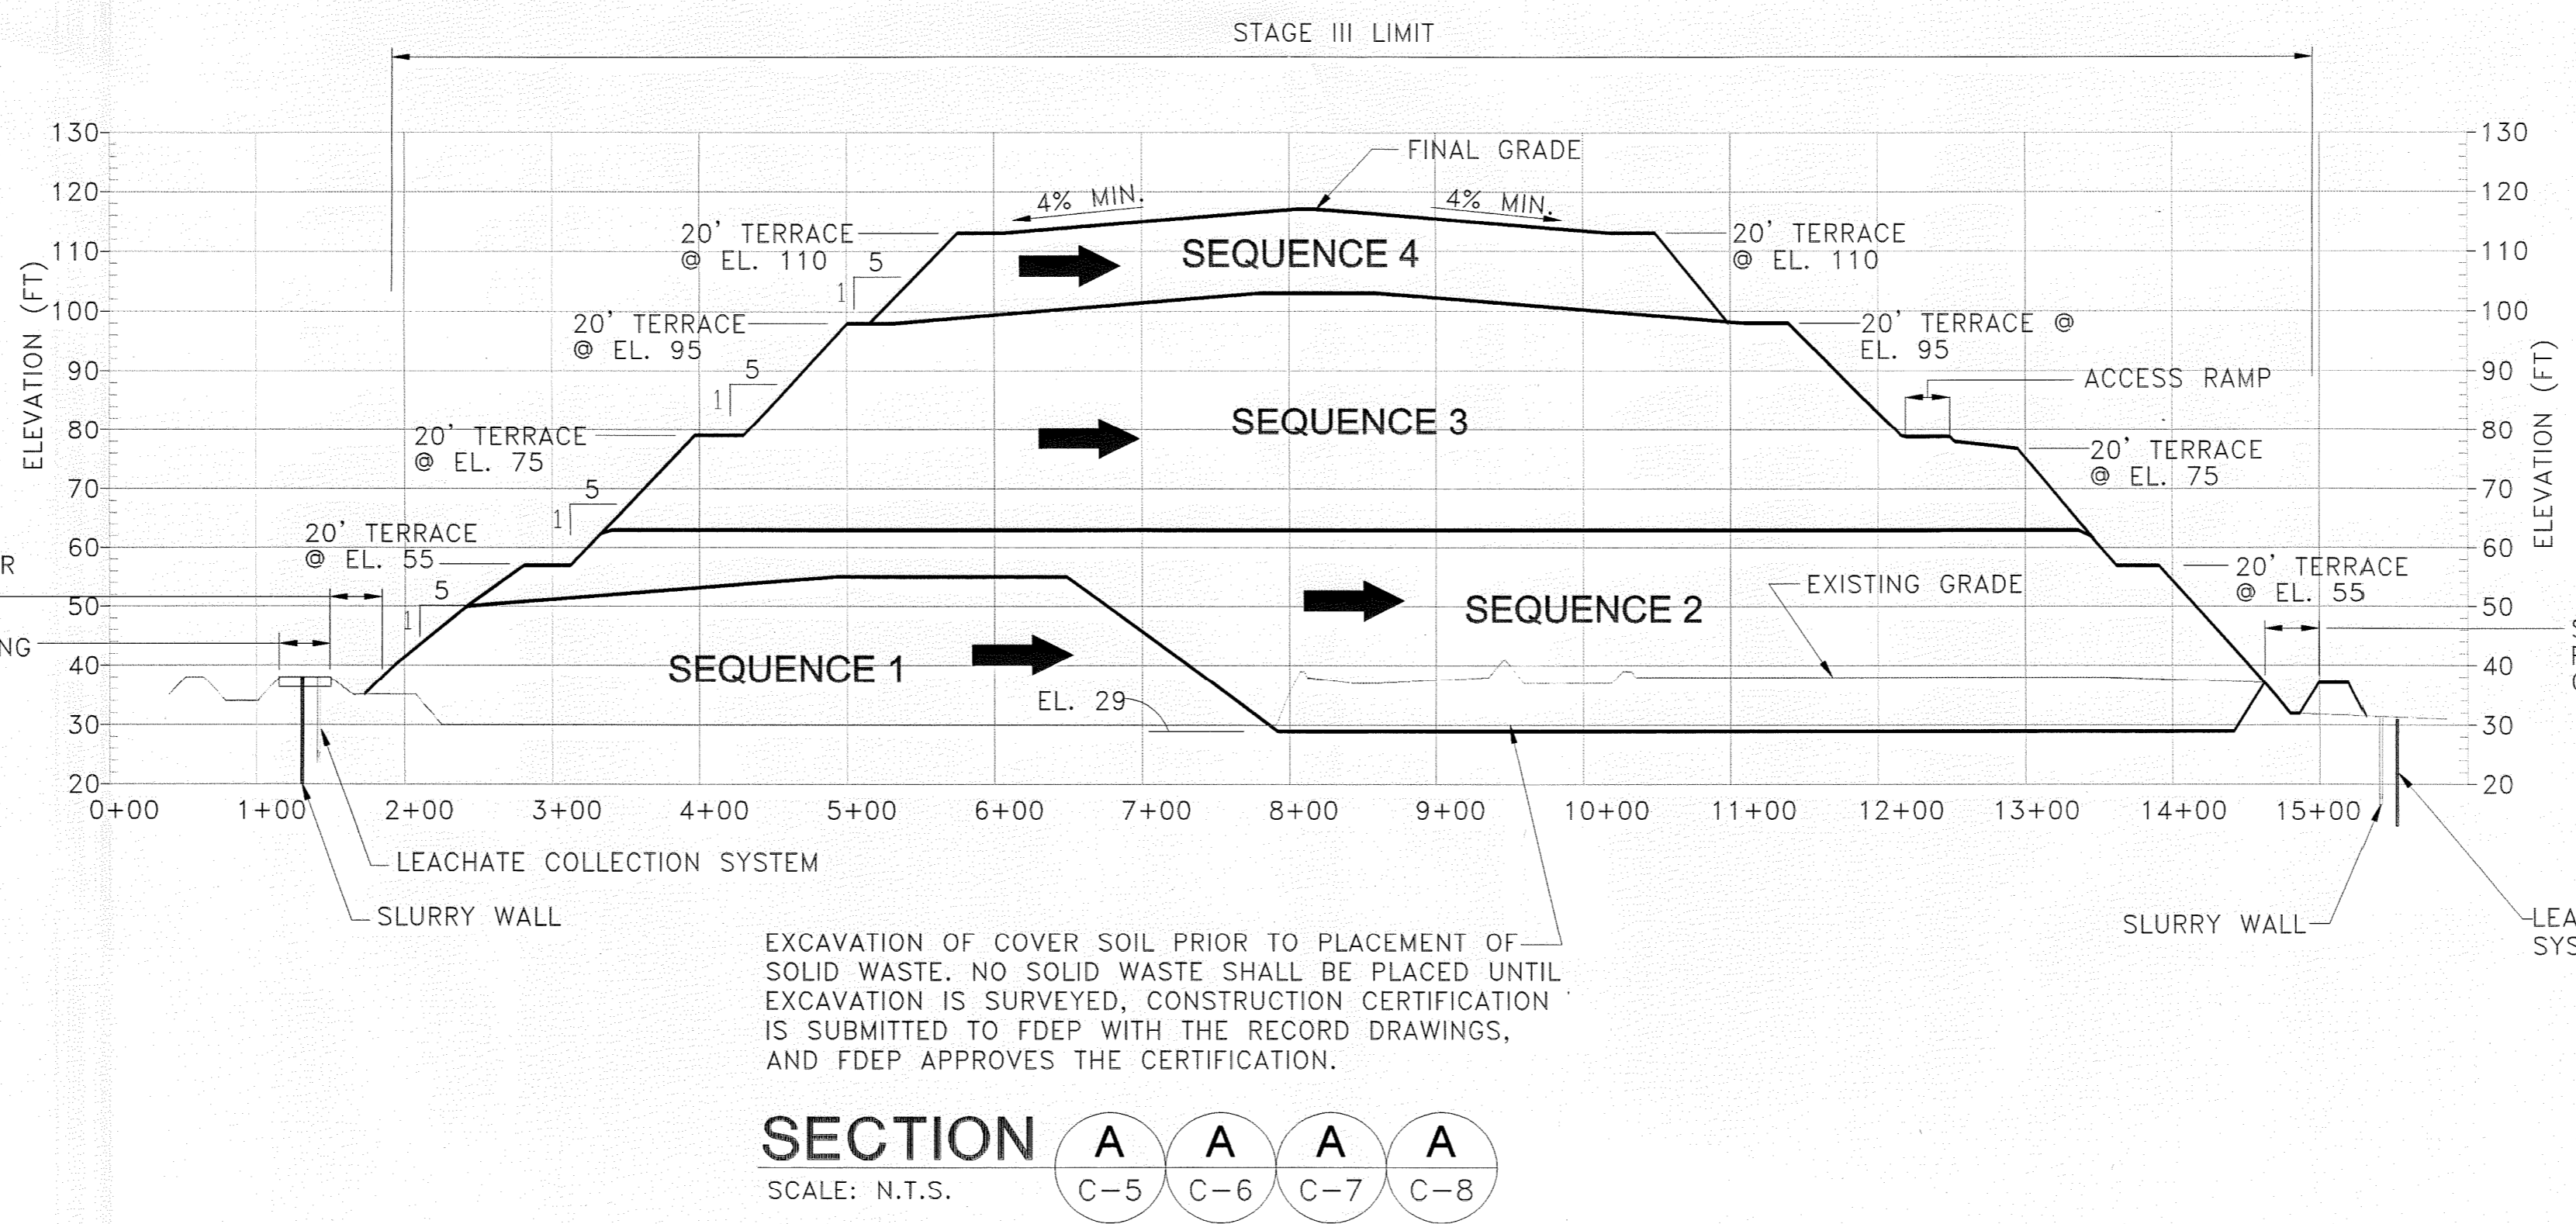

SECTION A A A A
SCALE: N.T.S. C-5 C-6 C-7 C-8

- ▲ -REVISED "SECTIONS A & B" TO INCLUDED LOCATION OF THE INTERIOR PERIMETER TOE OF SLOPE STORMWATER CONVEYANCE SYSTEM.
- REVISED "SECTION A" TO SHOW THE LOCATION OF SLURRY WALL AND LECHATE COLLECTION SYSTEM ON NORTH SIDE.
- REVISED "SECTION B" TO SHOW THE LOCATION OF THE LECHATE COLLECTION SYSTEM ON THE EAST SIDE.

FLORIDA DEPARTMENT OF ENVIRONMENTAL PROTECTION
MAY 18 2010
SOUTHWEST DISTRICT
TAMPA

C-11

PBS&J
482 South Keller Road
ORLANDO, FL 32810-6101
TEL. (407) 647-7275
FAX. (407) 647-0624
WWW.PBS&J.COM
POST-BUCKLEY, SCHUH & JERNIGAN, Inc.
d/b/a PBS&J
500 West Cypress Street Suite 200
Tampa, FL 33607
FBPR Certificate of Authorization No.: 24

CLIENT
MANATEE COUNTY
BOARD OF COUNTY COMMISSIONERS

PROJECT
LENA ROAD LANDFILL
FILL SEQUENCE PLAN

TASK
STAGE III - LANDFILL
CROSS SECTIONS

ORIGINAL NOV. 2009
REVISIONS:
1. JAN. 5, 2010
2.
3.
4.
5.

6.
7.
8.
9.
10.
11.
12.

Name: JOSEPH J. MINNER
Florida Professional Engineer
No. 100008517
Exp. 12/31/2011
Seal of the State of Florida
Professional Engineer
Civil

JOB NO. 100008517
DRAWN: RGC
DESIGN: RGC/JLM
CHECKED: JLM
Q.C.: DED
SHEET / #