

## **Avon Park Fire Department**

Joseph P. Trainor Fire Chief (813) 453-6557

August 18, 1995

To Whom It May Concern

FROM:

Joseph P. Trainor, Fire Chief

SUBJECT: Hazard Abatements at Florida Tire Terminal


Please find attached to this memo an overview of the above listed property. The prime requistite of this department is to maintain a series of 8' aisles at this facility; which enables us to effectively sustain a suppression effort. The constant maintenance (keeping the aisles unencumbered with tires) is imperative in whether this facility is termed hazardous to the surrounding properties or not. I have spoken with Mr. Robert Reisig concerning the aisles as well as some additional fire extinguishers and he has agreed to make the necessary changes. This department has always enjoyed a cooperative relationship with Mr. Reisig during my six plus years as the Fire Chief.

Should any questions arise as the result of this memo, please feel free to contact me at 941-453-6557.

Sincerely,

Joséph P. Trainor

Fire Chief

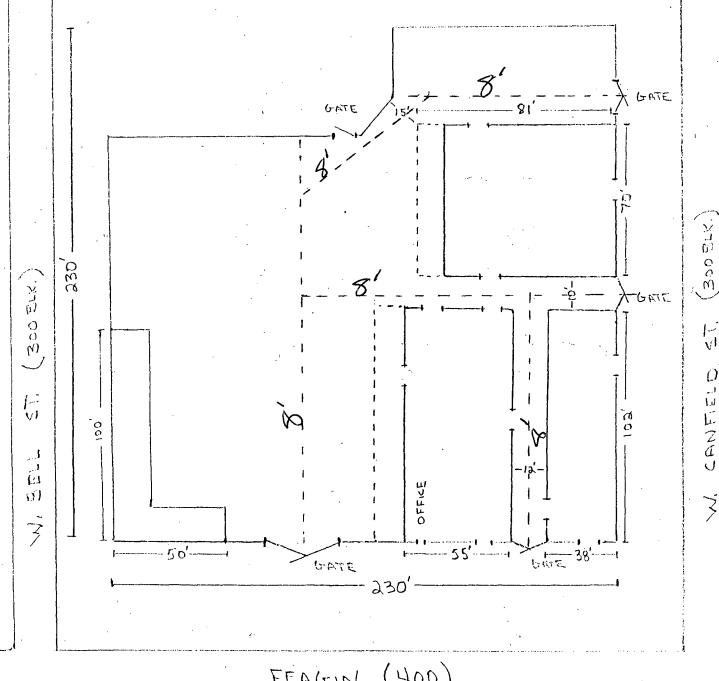

FEAGIN (400)

100001