

WASTE MANAGEMENT OF NORTH FLORIDA

Trail Ridge Landfill, Inc. 5110 U.S. Highway 301 South Baldwin, FL 32234-3608 P: 904.289.9100 F: 904.289.9013

October 27, 2010

Emerson Raulerson Florida Department of Environmental Protection 7825 Baymeadows Way, Suite 200B Jacksonville, FL 32256-7590

Re: Trail Ridge Landfill

Methane Monitoring Results/4th Qtr. 2010

FDEP Permit # 0013493-010-SC

I.D. #: NED/16/00033628

Dear Mr. Raulerson:

In accordance with Specific Condition #35 of the above referenced permit, enclosed please find the 4th Quarter 2010 Gas Monitoring Data for Trail Ridge Landfill. As indicated on the report, there was no detection of methane gas at the site.

If you have any questions or need additional information regarding this submittal, please contact me at (904) 289-9506, or email at eparker1@wm.com.

Respectfully Submitted,

Eric Parker, CHMM

Environmental Protection Manager

North Florida Market Area

cc: Greg Mathes, Waste Management
Jim Christiansen, Waste Management
James Getting, Waste Management
Brian Dolihite, Waste Management
Jeff Foster, City of Jacksonville
Brian Durden, FDEP

RECEIVED

OCT 28 2010

NORTHEAST DISTRICT DEP-JACKSONVILLE

TRAIL RIDGE LANDFILL QUARTERLY LANDFILL GAS MONITORING AND ACTIVITIES REPORT 4th QUARTER 2010

SIGNIFICANT ACTIVITIES

(1) Regular gas monitoring occurred on 10/25/2010 and is presented below. No gas was detected.

GAS MONITORING RESULTS

Date Monitored:

October 25, 2010

Analyst:

Robby Litherland

Instrument Type:

GEM 2000; Serial No: GM11214

• Calibration Acceptable: Yes; Span Gas 50% volume, response 49.5%, adjusted 50%


Water Level Instrument Type: Slope Indicator; Serial No.:19802

Weather Conditions; 81°F, Sunny, Winds South 8 Mph

Barometric Pressure: 30.04" Hg

MON. POINT	TIME	PRESSURE (inches w.c.)	METHANE (% by Vol. air)	METHANE (% LEL)	LIQUID LEVEL (FT TOC)	COMMENTS
GP-06	1053	N/A	0	0	0.0'	
GP-07	1049	N/A	0	0	0.0'	
GP-08	1042	N/A	0	0	0.0'	
GP-09	1037	N/A	0	0	0.0'	
GP-10	1033	N/A	0	0	0.0'	
GM-01	0959	N/A	0	0	N/A	Scale House South
GM-02	0957	N/A	0	0	N/A	Scale House North
GM-03.	1002	N/A	0	0	N/A	Admin. Building
GM-04	0947	N/A	0	0	N/A	1 st Floor Op's
GM-05	0939	N/A	0	0	N/A	2 nd Floor Op's

Comments: GP-are permanent probes; GM-are in structure locations

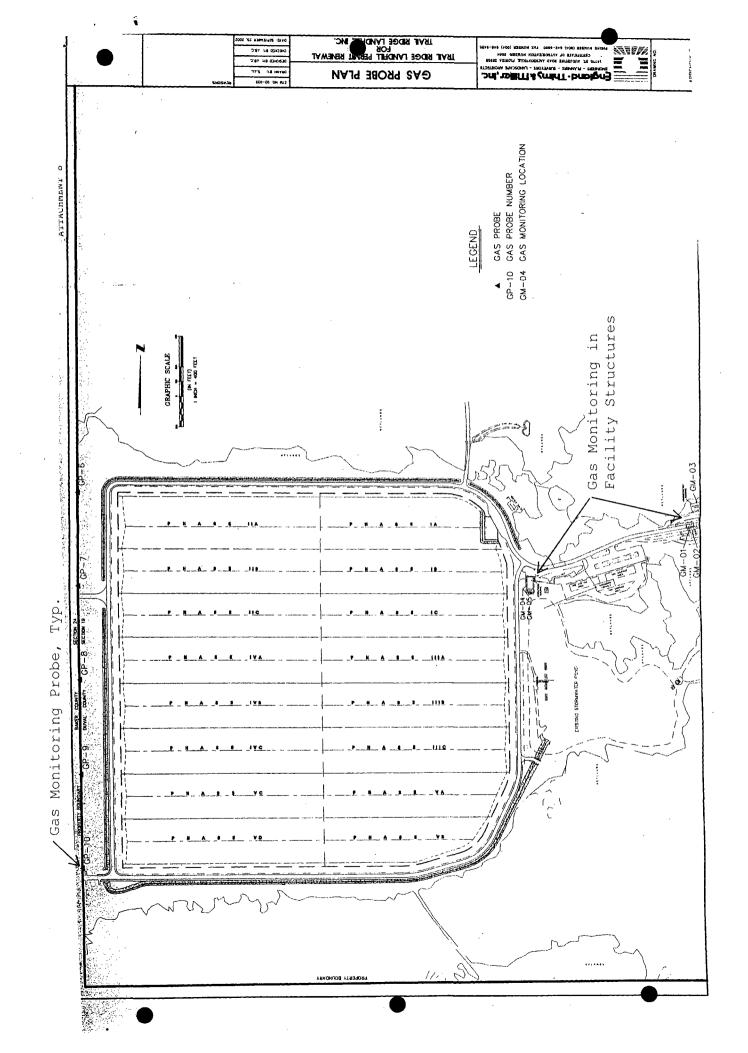

fins	UPS Next Day Air	Saver®	TIR WEIGHT DIMENSIONAL LARGE WEIGHT If Applicable Applicable	SHIPPER RELEASE 1P
CP3	Shipping Do	cument	CHAI	RGES 1P
	on back. Visit UPS.com® or call 1-800-F ormation and UPS Tariff/Terms and Conditi		S NEXT DAY AIR SAVER CHARGE	transperation The schare systemed by the UPS Tatil/Term to UPS Tatil/Term
TRACKING I	NUMBER 12 OTT 512 a	23 1000 4134	SATURDAY PICKUP. See instructions.	k serioanting the seckages shopser is num fathing per p
1 SHIPMENT FE SHIPPER'S UPS ACCOUNT	отт 512		OPTIONAL DECLARED VALUE FOR CARRIAGE S FOR GENERAL GOVERNMENT OF GENERAL OVER \$ STORY CONTROL OF STORY CONTROL OF STORY CONTROL OVER \$	ander the cacumitates 20,000, recept for a 20,000, recept for animal for which UPP assume
REFERENCE NUM			C.O.D. if C.O.D. enter amount to be collected and attach completed UPS C.O.D. tag to package.	e resumable with the second of
NAME	(1991) (A1SA)	TELEPHONE 904-289-9100	An Additional Handling Charge applies for certain items. See instructions.	1 is 5160, which is, partiagns, the manning partiagns is fripped in the definition of Articles
COMPANY	MANAGEMENT TRAIL R	IDGĖ	TOTAL CHARGES SULL SULL SULL SULL SULL SULL SULL SU	by this seceng rises the adi
STREET ADDRESS		ZIP CODE	SHIPPER'S METHOD ACCOUNT NUMBER RECEIVER PARTY CARD American Express Diner's Club MasterCard Visa PAYMENT IN SECTION 1 IN SECTION 9	we of each packing covered to the business exceed 501 for the limitations on UPS's table
BALDWI	N	FL 32234	1.000 0.700 0.000	PIRATION PROPERTY OF THE PROPE
2 EXTREMELY L NAME	JRGENT DELIVERY TO	TELEPHONE	THIRD PARTY'S COMPANY NAME	the shipper agress that the shipper agress that sharmore shipping to the sharmore shipping to the
COMPANY	to treet of	Find Nouveland	STREET ADDRESS ZIP CODE	THE STATE OF THE S
STREET ADDRESS	5 Bryliashus 1	ADEPT/FUR T/ Resident U.U.StC. Dev[]	Shipper authorizes UPS to act as toriwarding again for support combs and customs pages as Shipper certifies that these commodities, sechill capanted from the United States, where experted in accordance with the Expert Addingualsee #TEM 2010. Diversion contary to law is pr	orsipation or supplied to a new Angle of the
CITY AND STATE	outle, FL.	AIP CODE	It coported from the United States, where exported in accordance with the Export Additional Conference contact to be a top of the Export Additional Conference contact to the Export Additional Conference Confer	
			0201952542609 1/10 S SHIPPER'	S COPY

.